


LEGEND

- CLEANOUT/VENT
- LEACHATE SEEP COLLECTOR
- ABANDONED SEEP COLLECTOR
- PERIMETER FENCE
- PERIMETER DITCH

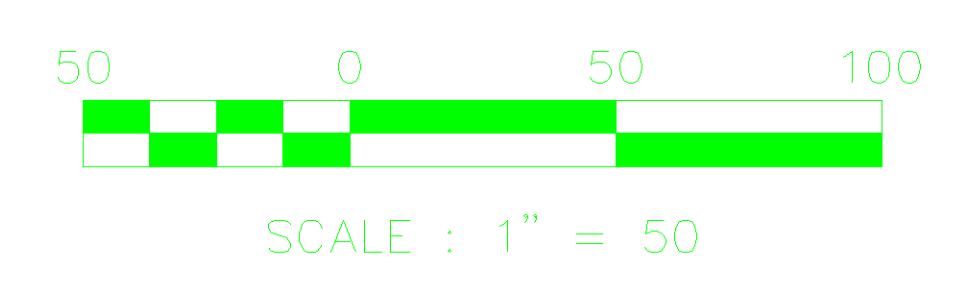

WEST VIRGINIA DIVISION OF ENVIRONMENTAL PROTECTION
 LANDFILL CLOSURE ASSISTANCE PROGRAM

FLEMING SANITARY LANDFILL CLOSURE
 POCATALICO, WEST VIRGINIA

LEACHATE SEEP COLLECTOR DRAINS - AS CONSTRUCTED

A E Associates, Ltd.
 ASSOCIATES, LTD. CHARLESTON, W. VA. (304) 346-0505

Designed:	Checked: L.R.B.	Scale: 1" = 50'
Drawn: A.B., T.E.	Date: 8/28/02	Sheet 4 of 4