



---

west virginia department of environmental protection

---

Office of Oil and Gas  
601 57<sup>th</sup> Street, S.E.  
Charleston, WV 25304  
(304) 926-0450  
fax: (304) 926-0452

Austin Caperton, Cabinet Secretary  
[www.dep.wv.gov](http://www.dep.wv.gov)

Wednesday, March 28, 2018  
WELL WORK PERMIT  
Horizontal 6A / New Drill

NORTHEAST NATURAL ENERGY LLC  
707 VIRGINIA STREET EAST  
STE 1200  
CHARLESTON, WV 25301

Re: Permit approval for KASSAY 2H  
47-061-01794-00-00

This well work permit is evidence of permission granted to perform the specified well work at the location described on the attached pages and located on the attached plat, subject to the provisions of Chapter 22 of the West Virginia Code of 1931, as amended, and all rules and regulations promulgated thereunder, and to any additional specific conditions and provisions outlined in the pages attached hereto. Notification shall be given by the operator to the Oil and Gas Inspector at least 24 hours prior to the construction of roads, locations, and/or pits for any permitted work. In addition, the well operator shall notify the same inspector 24 hours before any actual well work is commenced and prior to running and cementing casing. Spills or emergency discharges must be promptly reported by the operator to 1-800-642-3074 and to the Oil and Gas Inspector.

Please be advised that form WR-35, Well Operators Report of Well Work is to be submitted to this office within 90 days of completion of permitted well work, as should form WR-34 Discharge Monitoring Report within 30 days of discharge of pits, if applicable. Failure to abide by all statutory and regulatory provisions governing all duties and operations hereunder may result in suspension or revocation of this permit and, in addition, may result in civil and/or criminal penalties being imposed upon the operators.

Per 35 CSR 4-5.2.g this permit will expire in two (2) years from the issue date unless permitted well work is commenced. If there are any questions, please feel free to contact me at (304) 926- 0450.

James A. Martin  
Chief 

Operator's Well Number: KASSAY 2H  
Farm Name: PATTY A KASSAY  
U.S. WELL NUMBER: 47-061-01794-00-00  
Horizontal 6A New Drill  
Date Issued: 3/28/2018

# PERMIT CONDITIONS 470610179.4

West Virginia Code § 22-6A-8(d) allows the Office of Oil and Gas to place specific conditions upon this permit. Permit conditions have the same effect as law. Failure to adhere to the specified permit conditions may result in enforcement action.

## CONDITIONS

1. This proposed activity may require permit coverage from the United States Army Corps of Engineers (USACE). Through this permit, you are hereby being advised to consult with USACE regarding this proposed activity.
2. If the operator encounters an unanticipated void, or an anticipated void at an unanticipated depth, the operator shall notify the inspector within 24 hours. Modifications to the casing program may be necessary to comply with W. Va. Code § 22-6A-5a (12), which requires drilling to a minimum depth of thirty feet below the bottom of the void, and installing a minimum of twenty (20) feet of casing. Under no circumstance should the operator drill more than one hundred (100) feet below the bottom of the void or install less than twenty (20) feet of casing below the bottom of the void.
3. When compacting fills, each lift before compaction shall not be more than 12 inches in height, and the moisture content of the fill material shall be within limits as determined by the Standard Proctor Density test of the actual soils used in specific engineered fill, ASTM D698, Standard Test Method for Laboratory Compaction Characteristics of Soil Using Standard Effort, to achieve 95 % compaction of the optimum density. Each lift shall be tested for compaction, with a minimum of two tests per lift per acre of fill. All test results shall be maintained on site and available for review.
4. Operator shall install signage per § 22-6A-8g (6) (B) at all source water locations included in their approved water management plan within 24 hours of water management plan activation.
5. Oil and gas water supply wells will be registered with the Office of Oil and Gas and all such wells will be constructed and plugged in accordance with the standards of the Bureau for Public Health set forth in its Legislative rule entitled *Water Well Regulations*, 64 C.S.R. 19. Operator is to contact the Bureau of Public Health regarding permit requirements. In lieu of plugging, the operator may transfer the well to the surface owner upon agreement of the parties. All drinking water wells within fifteen hundred feet of the water supply well shall be flow tested by the operator upon request of the drinking well owner prior to operating the water supply well.
6. Pursuant to the requirements pertaining to the sampling of domestic water supply wells/springs the operator shall, no later than thirty (30) days after receipt of analytical data provide a written copy to the Chief and any of the users who may have requested such analyses.
7. 24 hours prior to the initiation of the completion process the operator shall notify the Chief or his designee.
8. During the completion process the operator shall monitor annular pressures and report any anomaly noticed to the chief or his designee immediately.
9. If any explosion or other accident causing loss of life or serious personal injury occurs in or about a well or well work on a well, the well operator or its contractor shall give notice, stating the particulars of the explosion or accident, to the oil and gas inspector and the Chief, within 24 hours of said accident.
10. During the casing and cementing process, in the event cement does not return to the surface, the oil and gas inspector shall be notified within 24 hours.

# PERMIT CONDITIONS 4706101794

11. The operator shall provide to the Office of Oil and Gas the dates of each of the following within 30 days of their occurrence: completion of construction of the well pad, commencement of drilling, cessation of drilling, completion of any other permitted well work, and completion of the well. Such notice shall be provided by sending an email to [DEPOOGNotify@wv.gov](mailto:DEPOOGNotify@wv.gov).

WW-6B  
(04/15)

API NO. 47- \_\_\_\_\_  
OPERATOR WELL NO. 2H  
Well Pad Name: Kassay

STATE OF WEST VIRGINIA  
DEPARTMENT OF ENVIRONMENTAL PROTECTION, OFFICE OF OIL AND GAS  
WELL WORK PERMIT APPLICATION

1) Well Operator: Northeast Natural Energy LLC 494498281 Monongalia Clay Blacksville  
Operator ID County District Quadrangle

2) Operator's Well Number: 2H Well Pad Name: Kassay

3) Farm Name/Surface Owner: Patty Kassay Public Road Access: County Route 25/3 (Yank Hollow Road)

4) Elevation, current ground: 1,534' Elevation, proposed post-construction: 1,534'

5) Well Type (a) Gas  Oil \_\_\_\_\_ Underground Storage \_\_\_\_\_

Other \_\_\_\_\_

(b) If Gas Shallow  Deep \_\_\_\_\_

Horizontal  \_\_\_\_\_

*MJK 3/8/2018*

6) Existing Pad: Yes or No Yes

7) Proposed Target Formation(s), Depth(s), Anticipated Thickness and Expected Pressure(s):  
Marcellus; 8,288'; 103'; 3,600 PSI

8) Proposed Total Vertical Depth: 8,288'

9) Formation at Total Vertical Depth: Marcellus

10) Proposed Total Measured Depth: 19,628.04'

11) Proposed Horizontal Leg Length: 10,722'

12) Approximate Fresh Water Strata Depths: 50' ; 1,120'

13) Method to Determine Fresh Water Depths: DRILLERS LOG FROM OFFSET WELLS

14) Approximate Saltwater Depths: 1,946' ; 2,320'

15) Approximate Coal Seam Depths: 125' ; 1,098'

16) Approximate Depth to Possible Void (coal mine, karst, other): N/A

17) Does Proposed well location contain coal seams directly overlying or adjacent to an active mine? Yes \_\_\_\_\_ No

(a) If Yes, provide Mine Info: Name: \_\_\_\_\_

Depth: \_\_\_\_\_

Seam: \_\_\_\_\_

Owner: \_\_\_\_\_

RECEIVED  
Office of Oil and Gas

MAR 16 2018

4706101794

WW-6B  
(04/15)

API NO. 47- \_\_\_\_\_  
OPERATOR WELL NO. 2H \_\_\_\_\_  
Well Pad Name: Kassay

18)

**CASING AND TUBING PROGRAM**

TYPE	Size (in)	New or Used	Grade	Weight per ft. (lb/ft)	FOOTAGE: For Drilling (ft)	INTERVALS: Left in Well (ft)	CEMENT: Fill-up (Cu. Ft.)/CTS
Conductor	24"	New	NA	94.71	40'	40'	GTS
Fresh Water	13-3/8"	New	J-55	54.5	1,220'	1,190'	CTS
Coal							
Intermediate	9-5/8"	New	J-55	40	2,780'	2,750'	CTS
Production	5-1/2"	New	P-110	20	19,628.04'	19,598.04'	4,641 Cu. Ft.
Tubing	2-7/8"	New	N-80	6.5	N/A	8,500'	N/A
Liners							

*MJK 3/8/2018*

TYPE	Size (in)	Wellbore Diameter (in)	Wall Thickness (in)	Burst Pressure (psi)	Anticipated Max. Internal Pressure (psi)	Cement Type	Cement Yield (cu. ft./k)
Conductor	24"	30"	.375	415		4,500 psi Grout	N/A
Fresh Water	13-3/8"	17 1/2"	.38"	2,760	2,000	Class A	1.23
Coal							
Intermediate	9-5/8"	12 1/4"	.395"	3,950	3,000	Class A	1.3
Production	5-1/2"	8 3/4"	.361"	12,530	9,700	50:50 Poz	1.21
Tubing	2-7/8"	N/A	.217"	10,570	3,600	N/A	N/A
Liners							

**PACKERS**

Kind:				
Sizes:				
Depths Set:				

RECEIVED  
Office of Oil and Gas

MAR 16 2018

Page 2 of 3

WV Department of  
Environmental Protection

19) Describe proposed well work, including the drilling and plugging back of any pilot hole:

Drilling and completion of a horizontal Marcellus well. The well will be drilled on air to an approximate depth of 7,000' TVD/MD. The well will then be horizontally drilled on fluid from KOP to approximately 8,288' TVD / 19,628.04' MD along a combination of 148° and 141° azimuths.

20) Describe fracturing/stimulating methods in detail, including anticipated max pressure and max rate:

Multi-stage / high-rate slickwater fracture treatment using various size sands as proppant. First stage will be initiated via pressurization against a burst disc ran in the production casing string or perforated with coiled tubing. Subsequent stages will be perforated with pumped down guns ran on wireline. Individual stages will be isolated with composite frac plugs. Maximum pump rate during any stage will be 100 BPM with a maximum allowable surface pressure of 9,500 PSI. Composite bridge plugs will be set at the end of the last stage to isolate the treated formation.

21) Total Area to be disturbed, including roads, stockpile area, pits, etc., (acres): N/A

22) Area to be disturbed for well pad only, less access road (acres): N/A

23) Describe centralizer placement for each casing string:

Surface and intermediate casing strings will have bow spring centralizers placed every third joint (~120') from the shoe joint to surface. Production casing will have rigid body centralizers placed at a minimum of every other joint (~160') from TD to surface.

24) Describe all cement additives associated with each cement type:

Surface string cement will be a Class A + Max 3% bwoc Calcium Chloride Fresh Water blend. Intermediate string cement will be a Class A Cement + Max 3% bwoc Calcium Chloride + Fresh Water. Production string cement will be (50:50) Poz (Fly Ash):Type I Cement with a gas migration additive.

25) Proposed borehole conditioning procedures:

Surface string will use a 25.0 bbls Gel Pill + LCM + 25 lbs Cello Flake + 20 lbs/bbl Bentonite @ 8.4 ppg & 10 bbls fresh water spacer prior to cement. Intermediate string will use a 25.0 bbls Gel Pill + LCM + 25 lbs Cello Flake + 20 lbs/bbl Bentonite @ 8.4 ppg & 10 bbls fresh water spacer prior to cement. Production string will use a 50.0 bbls SealBond 25 + 1 gal/bbl US-40 + 275 lbs/bbl Barite + 1 gal/bbl SS-2 Spacer @ 13.5 ppg prior to cement.

RECEIVED  
Office of Oil and Gas

MAR 16 2018

\*Note: Attach additional sheets as needed.

# NORTHEAST NATURAL ENERGY, LLC

Location: Monongalia County, WV  
 Field: Monongalia  
 Facility: Kassay Pad


Slot: Slot #02  
 Well: Kassay 2H  
 Wellbore: Kassay 2H PWB



Type	Hole Size	Casing Size	Grade		GL Depth (Csg)
Conductor	28"	24"	NA		40'
Surface	17-1/2"	13-3/8"	J-55	54.5	1190'
Intermediate	12-1/4"	9-5/8"	J-55	40	2750'

Location Information				
Facility Name	Grid East (US ft)	Grid North (US ft)	Latitude	Longitude
Kassay Pad	1772945.870	422886.830	39°39'30.118"N	80°11'40.564"W
Slot	Local N (ft)	Local E (ft)	Grid East (US ft)	Grid North (US ft)
Slot #02	-13.93	26.53	1772972.200	422882.900
Ground Level (GL) to Ground level (At Slot, Slot #02)				0ft
Mean Sea Level to Ground level (At Slot, Slot #02)				-1534ft
Ground Level (GL) to Mean Sea Level				1534ft

Formation	Depth (KBTVD)
Tully	8040'
Hamilton	8090'
Upper Marcellus	8198'
Lower Marcellus	8246'
Onondaga	8301'

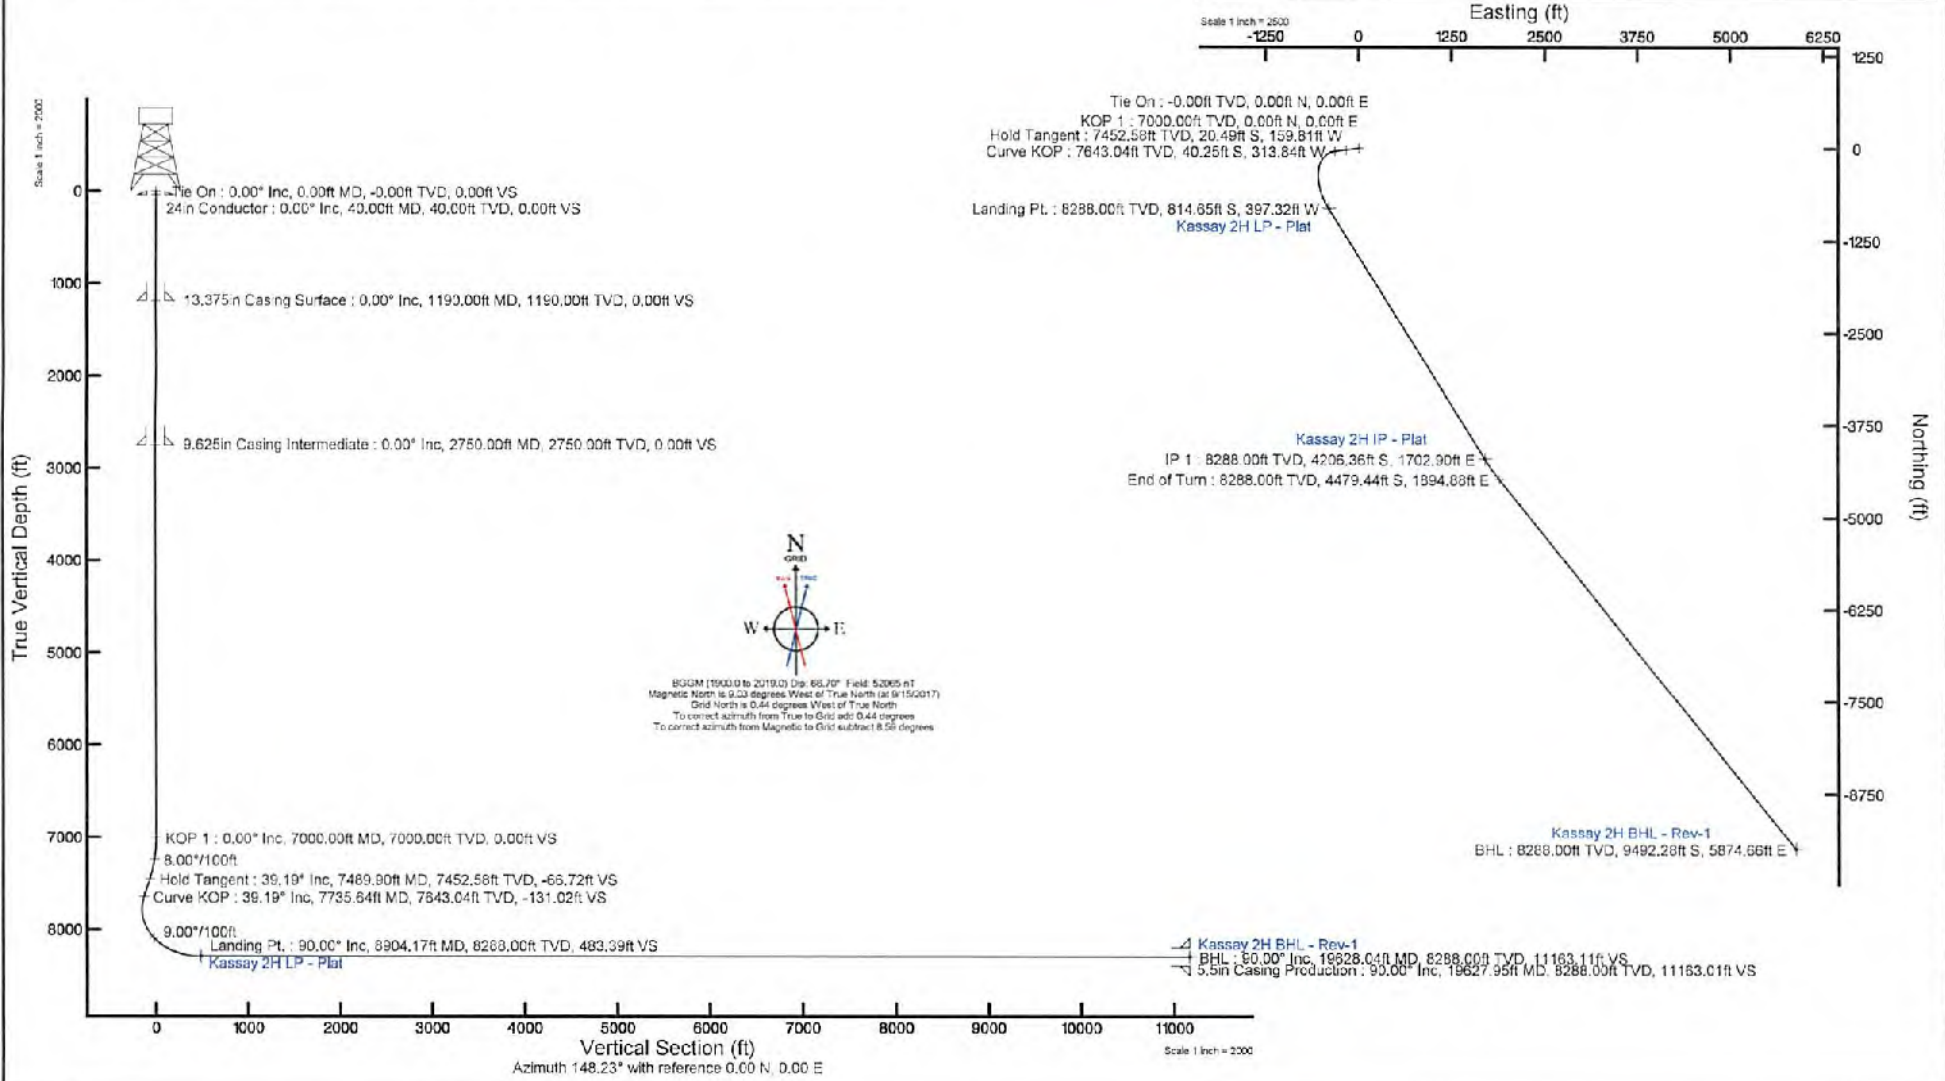

4706101794

## Northeast Natural Energy LLC Mine Contingency Plan



On all wells drilled, Northeast Natural Energy LLC ("NNE") has contingency strategies in place should an unanticipated void or mine be encountered while drilling the surface section of the well. If encountered, any accumulated gases will be diverted a safe distance away from the drilling operations through the blooey line and/or flare.


All casings programs submitted to the state incorporate the use of a 24" conductor over the previously used 20" that has long been the industry standard for a typical Marcellus design. The use of 24" conductor casing allows the use of a 22" bit to ream the surface hole, and drill 50' below the void to run a string of 18-5/8" 87.50#/ft J-55 through the section when needed.

The 18-5/8" would be set 30-50' below the void with cement baskets placed directly above and below. The section of pipe below the void would be cemented using the balance method with 100% excess. The section above the void would be cemented separately by using remedial top fill techniques and 30% excess.


With the use of these string sizes and techniques, the surface and intermediate strings do not need to be altered. After a proper WOC time, the surface section of the well would continue to be drilled with a 17-1/2" bit and the 13-3/8" 54.50#/ft freshwater casing would be set at the originally permitted depth.

*\*The diagram below visually shows the alternative casing plan should an unanticipated void be encountered.*

### Casing Schematic w/ Mine String

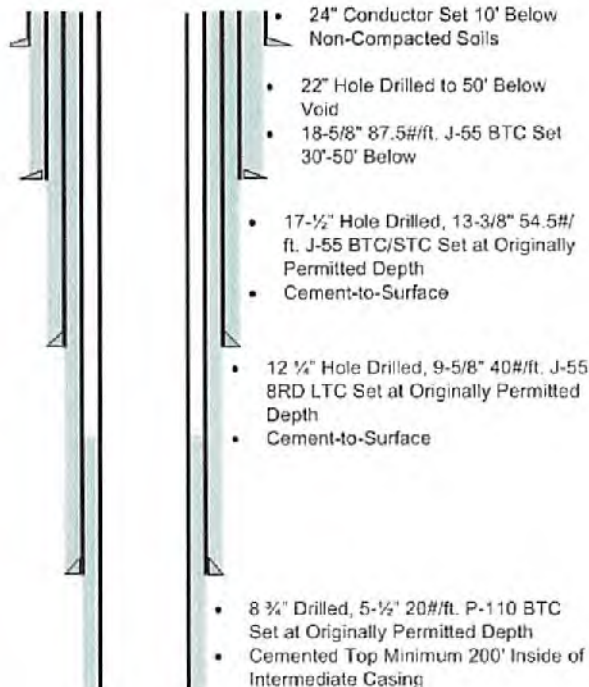

### Casing Schematic w/o Mine String

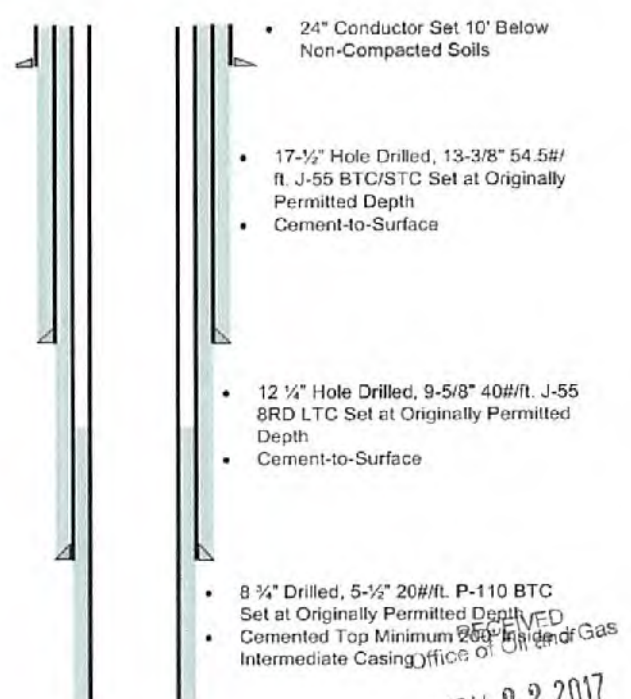

RECEIVED  
Office of Oil and Gas  
NOV 22 2017  
WV Department of  
Environmental Protection  
11/11 - IC




### Kassay 2H Area of Review

API Number	Well Name	Well Number	Operator	Latitude (NAD 27)	Longitude (NAD 27)	TMP	TVD	Comments
47-061-01337	Nehemiah Kassay et al	6L2	Noumenon Corp, a WV Corp	39.658513	-80.197656	4-17-48	670	Plugged 10-13-2015
47-061-00516	Albert Tennant	1	NNE Resources, LLC	39.650941	-80.192535	4-17-58	2027	Big Injun
47-061-71540	Ilean M Matteo	NA	NA	39.652233	-80.192549	4-17-77.1	NA	Pre 1929
47-061-00839	Goldie E West	NA	Consolidation Coal Co.	39.639051	-80.181091	4-20-20.1	NA	Plugged 09-11-1987
47-061-00524	James S Thomas II	NA	Consolidation Coal Co.	39.638036	-80.179028	4-20-20.1	NA	Plugged 02-28-1992
47-061-00525	Thomas Family Revocable Trust	6	NNE Resources, LLC	39.637049	-80.179473	4-20-65	NA	Plugged 09-23-2016
47-061-00518	S A & R R Holmes	1	NNE Resources, LLC	39.635785	-80.177947	4-21-43	NA	Plugged 10-12-2015
47-061-00694	Ilean Morton Matteo	1	Consolidation Coal Co.	39.654711	-80.193662	4-17-59	NA	Plugged 08-15-1983

RECEIVED  
 Office of Oil and Gas  
 NOV 22 2017  
 NY Department of  
 Environmental Protection

4706101794

# KASSAY 2H EXISTING GAS WELLS NOVEMBER 2, 2017

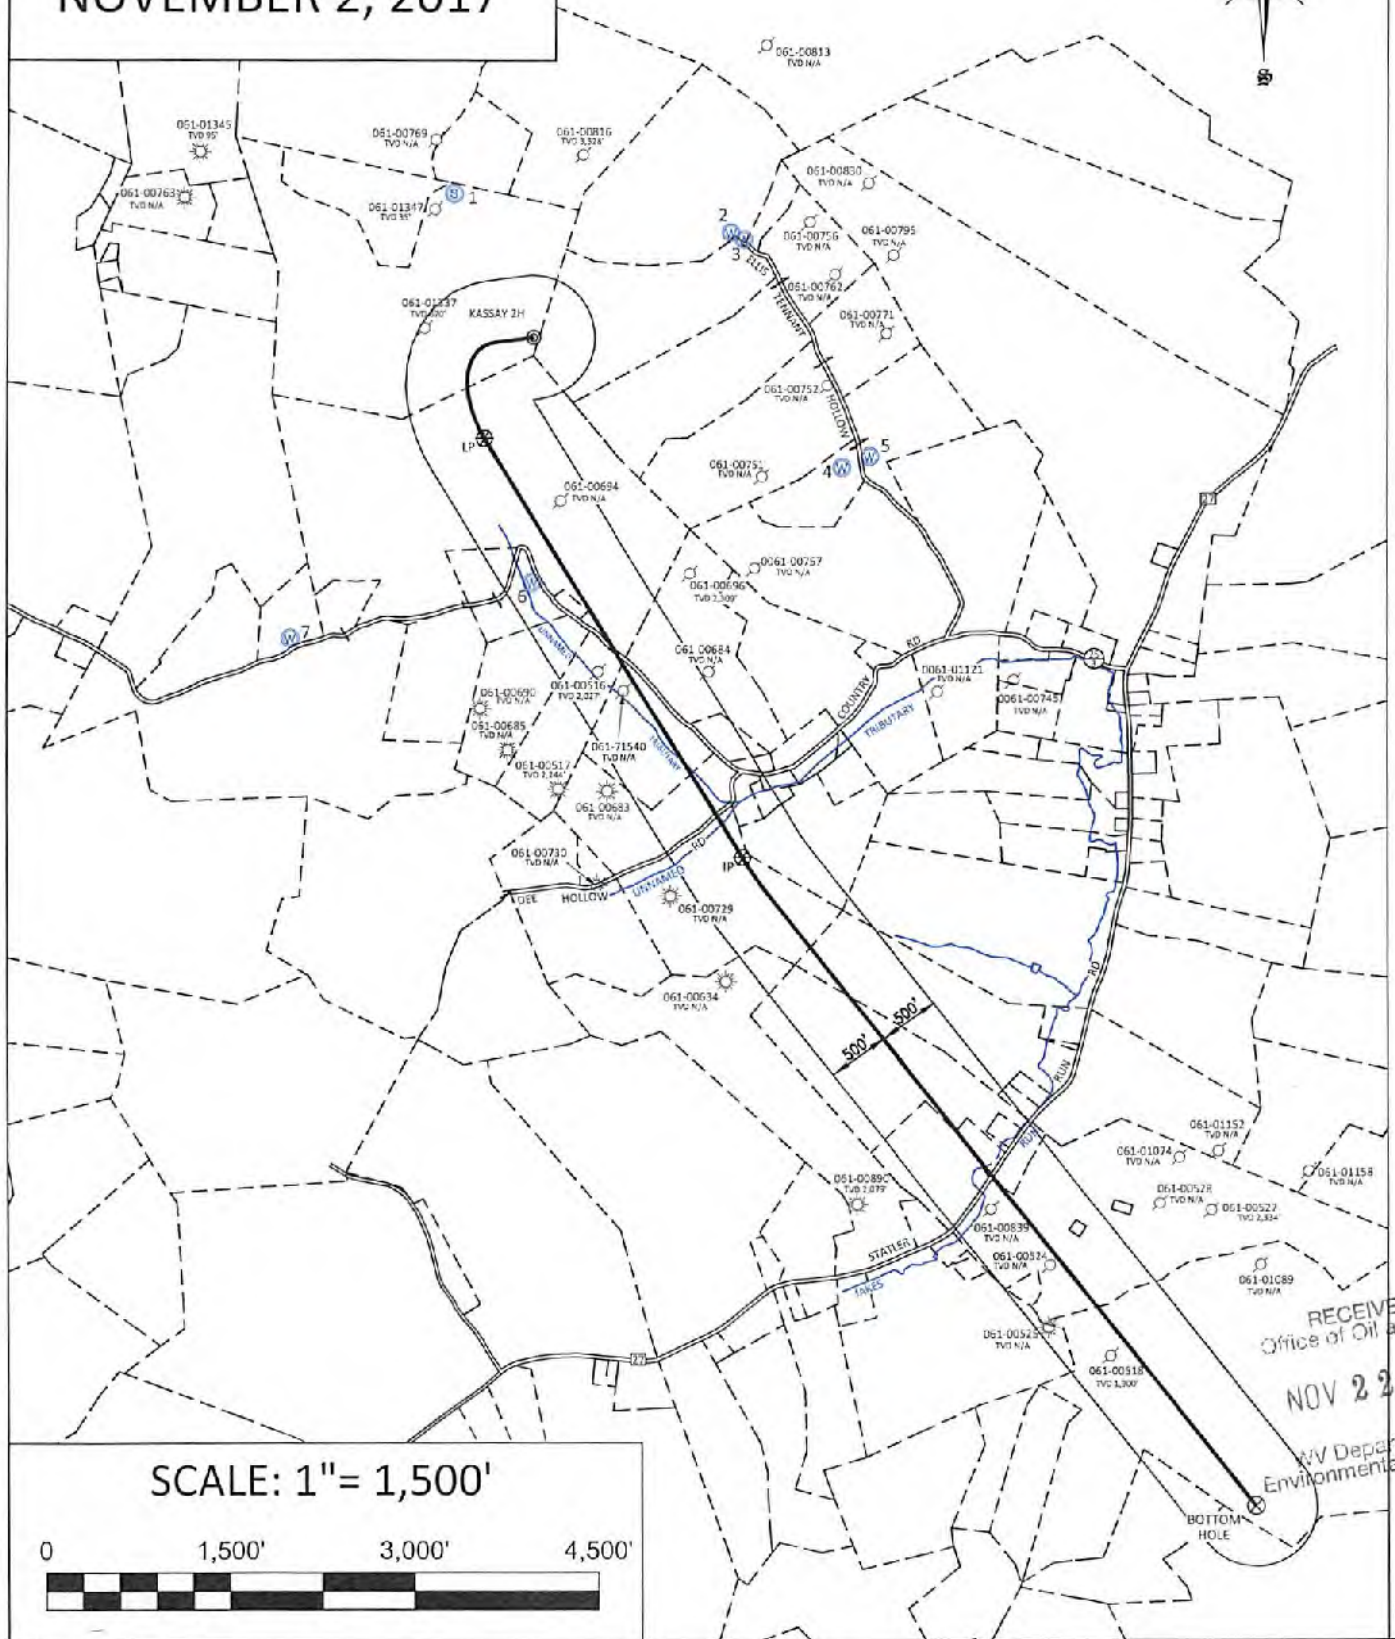

RECEIVED  
Office of Oil and Gas  
NOV 22 2017  
WV Department of  
Environmental Protection

WW-9  
(4/16)

API Number 47 - \_\_\_\_\_ - \_\_\_\_\_  
Operator's Well No. Kassay 2H

STATE OF WEST VIRGINIA  
DEPARTMENT OF ENVIRONMENTAL PROTECTION  
OFFICE OF OIL AND GAS

FLUIDS/ CUTTINGS DISPOSAL & RECLAMATION PLAN

Operator Name Northeast Natural Energy LLC OP Code 494498281

Watershed (HUC 10) Dunkard Creek Quadrangle Blacksville, WV

Do you anticipate using more than 5,000 bbls of water to complete the proposed well work? Yes  No

Will a pit be used? Yes  No

If so, please describe anticipated pit waste: N/A

Will a synthetic liner be used in the pit? Yes  No  If so, what ml.? N/A

Proposed Disposal Method For Treated Pit Wastes:

- Land Application
- Underground Injection ( UIC Permit Number \_\_\_\_\_ )
- Reuse (at API Number unknown at this time, TBD )
- Off Site Disposal (Supply form WW-9 for disposal location)
- Other (Explain \_\_\_\_\_)

Will closed loop system be used? If so, describe: Yes, Please See Attachment "A"

Drilling medium anticipated for this well (vertical and horizontal)? Air, freshwater, oil based, etc. Air- Vertical; Oil Based - Curve & Horizontal

-If oil based, what type? Synthetic, petroleum, etc. Synthetic Oil Based Mud

Additives to be used in drilling medium? Organophilic Clay Viscosifiers, Lime, Unsaturated Fatty Acids, CaCl, Barite, Emulsifiers, Mica LCM, Water Loss Agents

Drill cuttings disposal method? Leave in pit, landfill, removed offsite, etc. Removed Offsite - Please See Attachment "A"

-If left in pit and plan to solidify what medium will be used? (cement, lime, sawdust) \_\_\_\_\_

-Landfill or offsite name/permit number? Please See Attachment "A"

Permittee shall provide written notice to the Office of Oil and Gas of any load of drill cuttings or associated waste rejected at any West Virginia solid waste facility. The notice shall be provided within 24 hours of rejection and the permittee shall also disclose where it was properly disposed.

I certify that I understand and agree to the terms and conditions of the GENERAL WATER POLLUTION PERMIT issued on August 1, 2005, by the Office of Oil and Gas of the West Virginia Department of Environmental Protection. I understand that the provisions of the permit are enforceable by law. Violations of any term or condition of the general permit and/or other applicable law or regulation can lead to enforcement action.

I certify under penalty of law that I have personally examined and am familiar with the information submitted on this application form and all attachments thereto and that, based on my inquiry of those individuals immediately responsible for obtaining the information, I believe that the information is true, accurate, and complete. I am aware that there are significant penalties for submitting false information, including the possibility of fine or imprisonment.

Company Official Signature Hollie Medley  
Company Official (Typed Name) Hollie Medley  
Company Official Title Regulatory Manager

RECEIVED  
Office of Oil and Gas  
NOV 22 2017

WV Department of  
Environmental Protection

Subscribed and sworn before me this 15 day of November, 2017

[Signature]  
My commission expires 9/25/2020



4700301394

My Commission Expires 8/28/2020  
 Morgantown, WV 26505  
 188 Meadowdale Townhomes  
 Michael Eisenbaun  
**NOTARY PUBLIC**  
 STATE OF WEST VIRGINIA  
 OFFICIAL SEAL



*[Faint handwritten text]*

Form WW-9

Operator's Well No. Kassay 2H

Northeast Natural Energy LLC

Proposed Revegetation Treatment: Acres Disturbed 15.85 Prevegetation pH 5-7

Lime 2 Tons/acre or to correct to pH 7

Fertilizer type 19-19-19

Fertilizer amount 300 lbs/acre

Mulch 2 Tons/acre

Seed Mixtures

Temporary			Permanent		
Seed Type	lbs/acre		Seed Type	lbs/acre	
Orchard Grass	46		Orchard Grass	46	
Red Clover	8		Red Clover	8	
Tetraploid Perennial Rye	16		Tetraploid Perennial Rye	16	
Timothy 15	Annual Rye	15	Timothy 15	Annual Rye	15

Attach:

Maps(s) of road, location, pit and proposed area for land application (unless engineered plans including this info have been provided). If water from the pit will be land applied, include dimensions (L x W x D) of the pit, and dimensions (L x W), and area in acreage, of the land application area.

Photocopied section of involved 7.5' topographic sheet.

Plan Approved by: [Signature]

Comments:

Title: INSPECTOR

Date: 11/16/2017

Field Reviewed?  Yes  No

RECEIVED  
Office of Oil and Gas  
NOV 22 2017  
WV Department of  
Environmental Protection

Attachment A to WW-9

Northeast Natural Energy LLC (“NNE”) plans to utilize a closed loop process for its drilling of the Kassay 2H well. Return flow from the well will be separated into its liquid and solid form. Liquids will be held in steel tanks and reused in the drilling and completion process or disposed of at an approved facility listed below. Solids removed from the stream will be diverted to steel half-round tanks where they will be solidified on site and taken to disposal as they are accumulated.

Kassay 2H Drill Cuttings will be taken to disposal at one or more of the following disposal/approved waste facilities, unless listed facilities are no longer approved to accept waste at time of disposal:

- Westmoreland Landfill (Tervita) – Belle Vernon, PA (Permit # 100277)
- Meadowfill Landfill (Waste Management) – Bridgeport, WV (Permit # SWF 103298)
- Max Environmental – Yukon, PA (PAD004835146 and 301071)
- Max Environmental – Bulger, PA (PAD059087072 and 301359)
- Chestnut Valley Landfill (Advanced Disposal) – Export, PA (Permit # 101421)

NNE plans to reuse and recycle all flowback fluid and/or reach out to other operators in the area who may be able to reuse and recycle such fluid. However, in the event that reuse is not obtainable the fluid will be disposed of at one, or multiple, of the following disposal/approved waste facilities unless listed facilities are no longer approved to accept waste at time of disposal:

- Fairmont Brine Processing (WV NPDES #0116408)
- Green Hunter M. E. Elder 1 Disposal Well (Permit # 47-085-05151)
- Green Hunter Mason 1 Disposal Well (Permit #47-085-09721)
- Green Hunter Warren Disposal Well (Permit #34-121-2-3995)
- Green Hunter Travis Unit Disposal Well (Permit #34-121-2-4086)
- Viking Energy Corporation 20320 Disposal Well (Permit#47-039-02210)
- Ohio Oil Gathering Killbuck Disposal Well (Permit #34-075-24527)
- Ohio Oil Gathering Moran Disposal Well (Permit #34-089-24792)
- Ohio Oil Gathering Bells Run Disposal Well (Permit #34-167-29395)
- Ohio Oil Gathering Long Run Disposal Well (Permit #34-167-29658)
- Ohio Oil Gathering Newell Run Disposal Well (Permit #34-167-29685)
- Appalachian Oil Purchaser Greens Run Disposal Well (Permit #2D0732540)
- Appalachian Oil Purchaser BW#4 Disposal Well (Permit # 2D0732523)

RECEIVED  
Office of Oil and Gas

NOV 22 2017

WV Department of  
Environmental Protection



northeast  
NATURAL ENERGY

**Kassay 2H  
SITE SAFETY PLAN**

November 8, 2017


*James J. Kato*  
*11/16/2017*

RECEIVED  
Office of Oil and Gas

NOV 22 2017


WV Department of  
Environmental Protection

WELL NAME: KASSAY No. 2H  
QUAD: BLACKSVILLE, WV

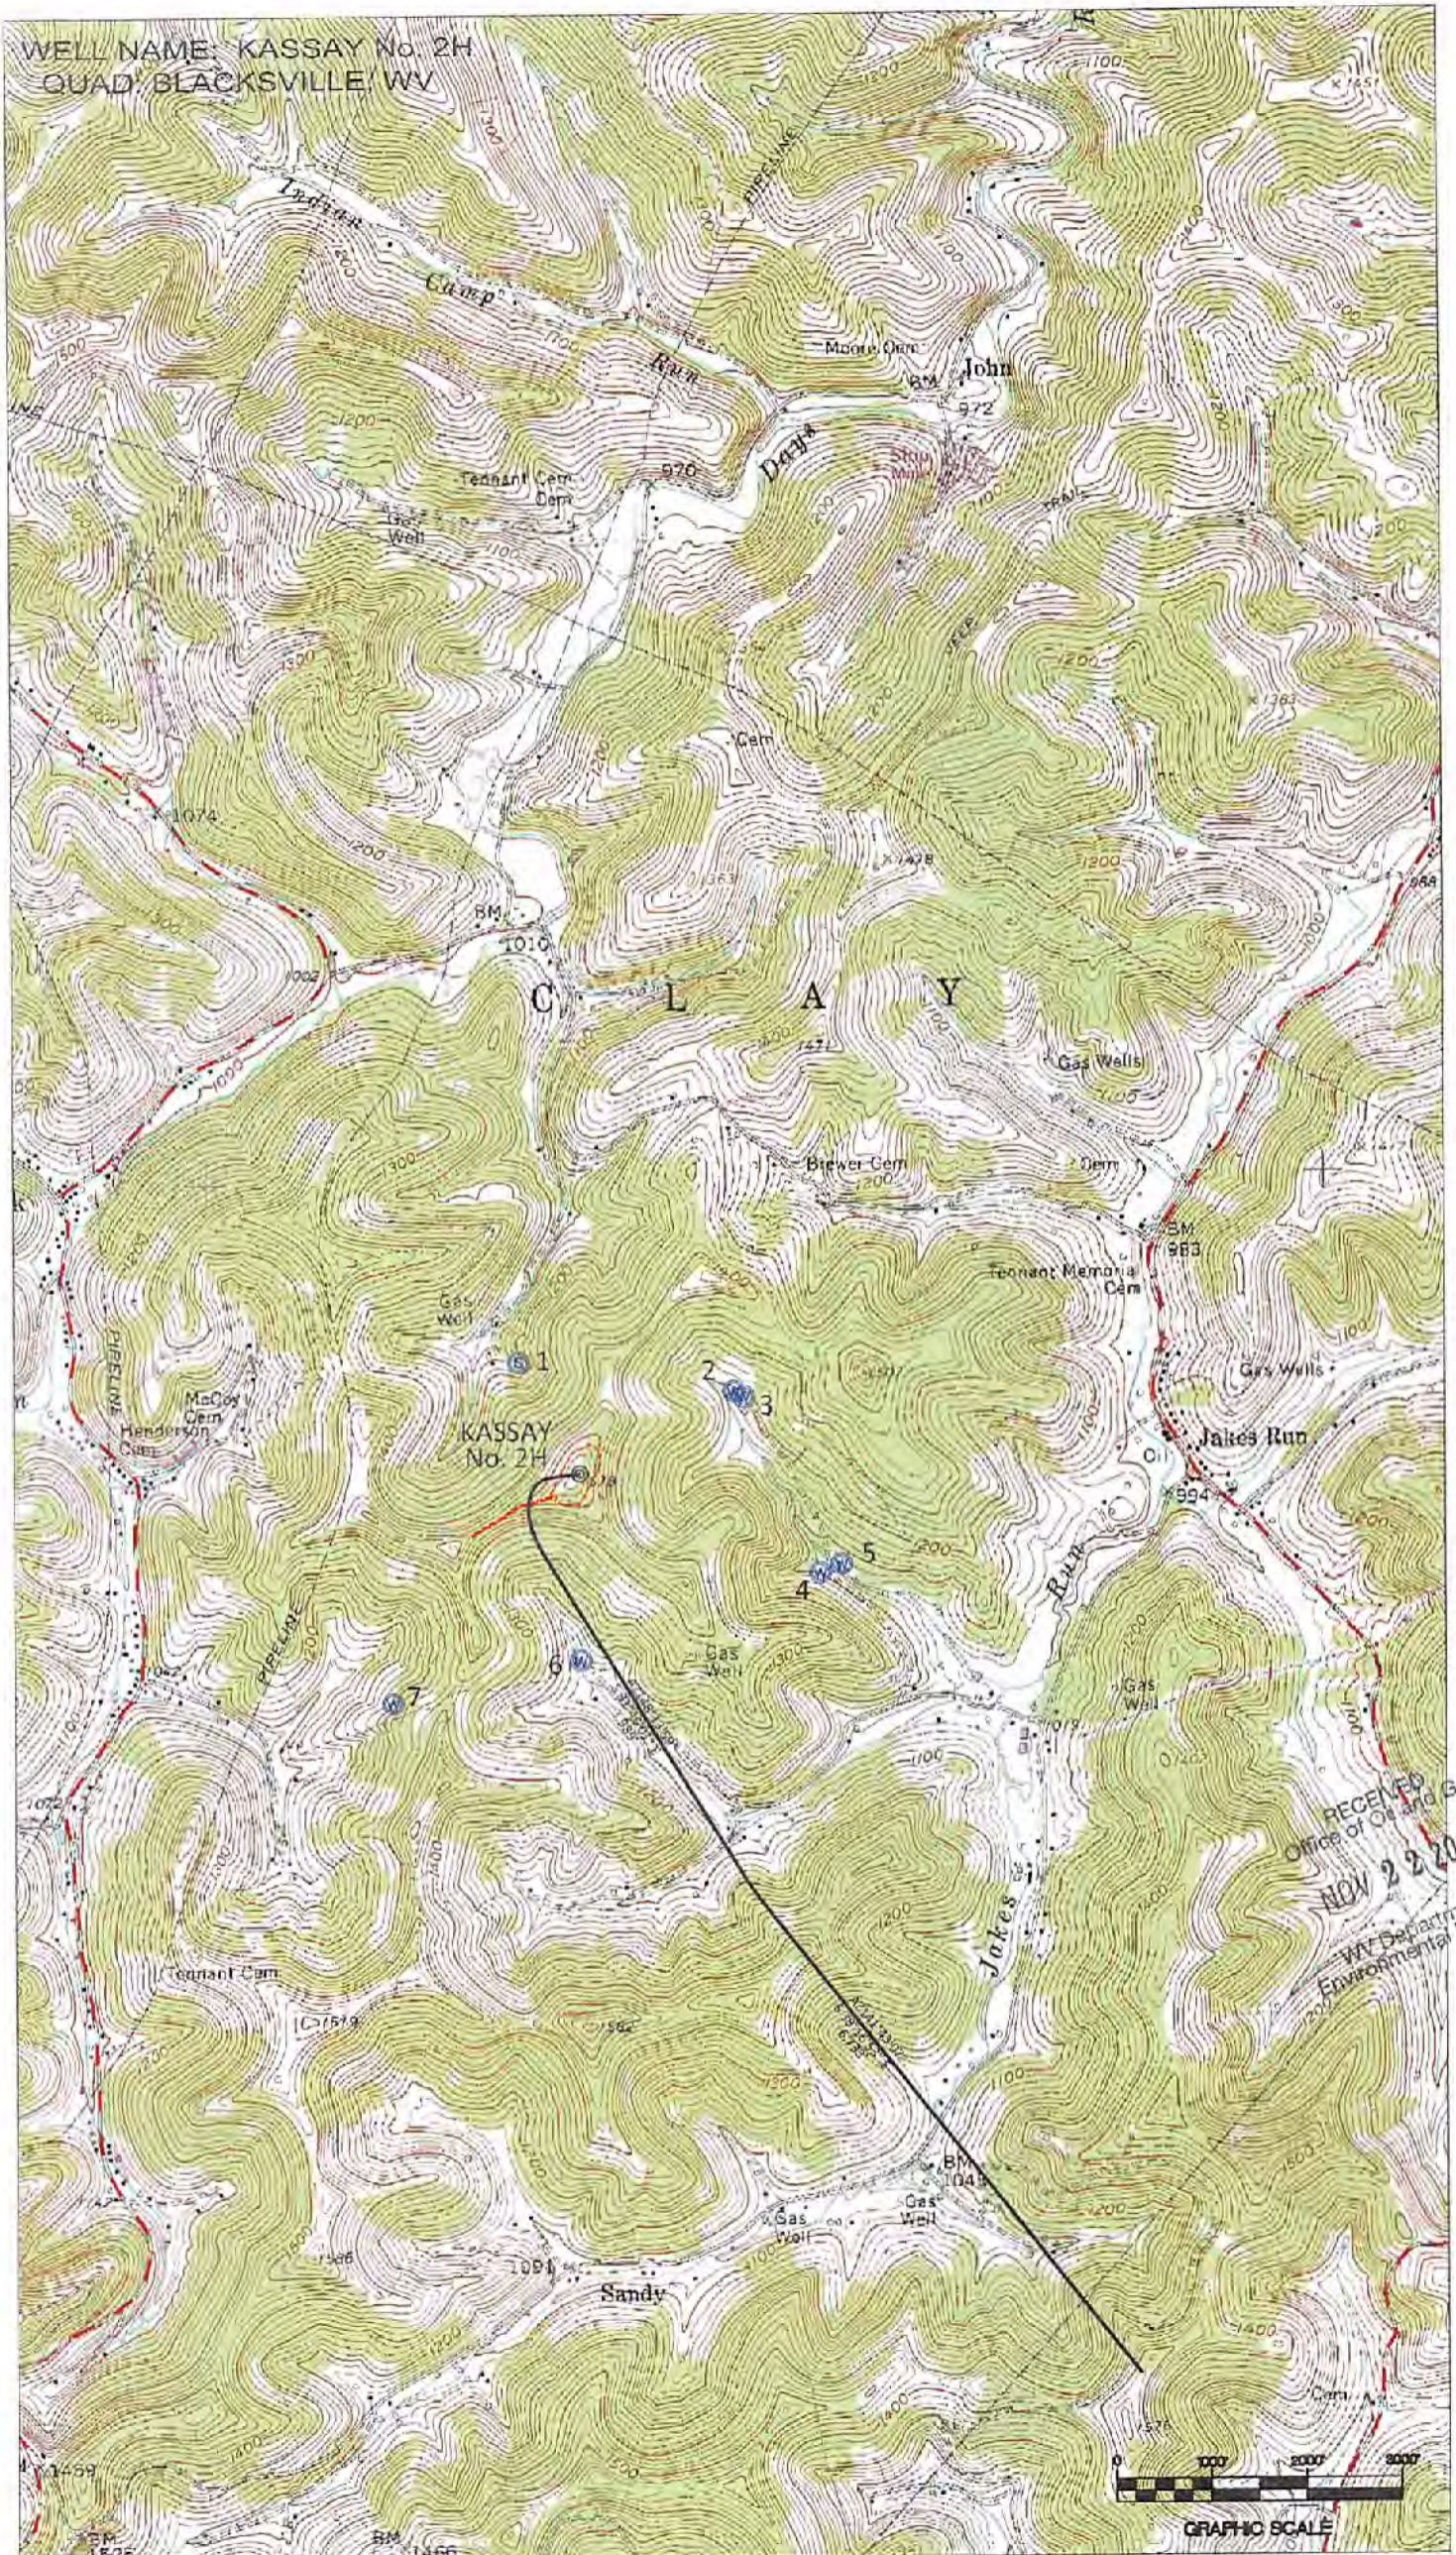

RECEIVED  
Office of Oil and Gas  
NOV 22 2017  
WV Department of  
Environmental Protection



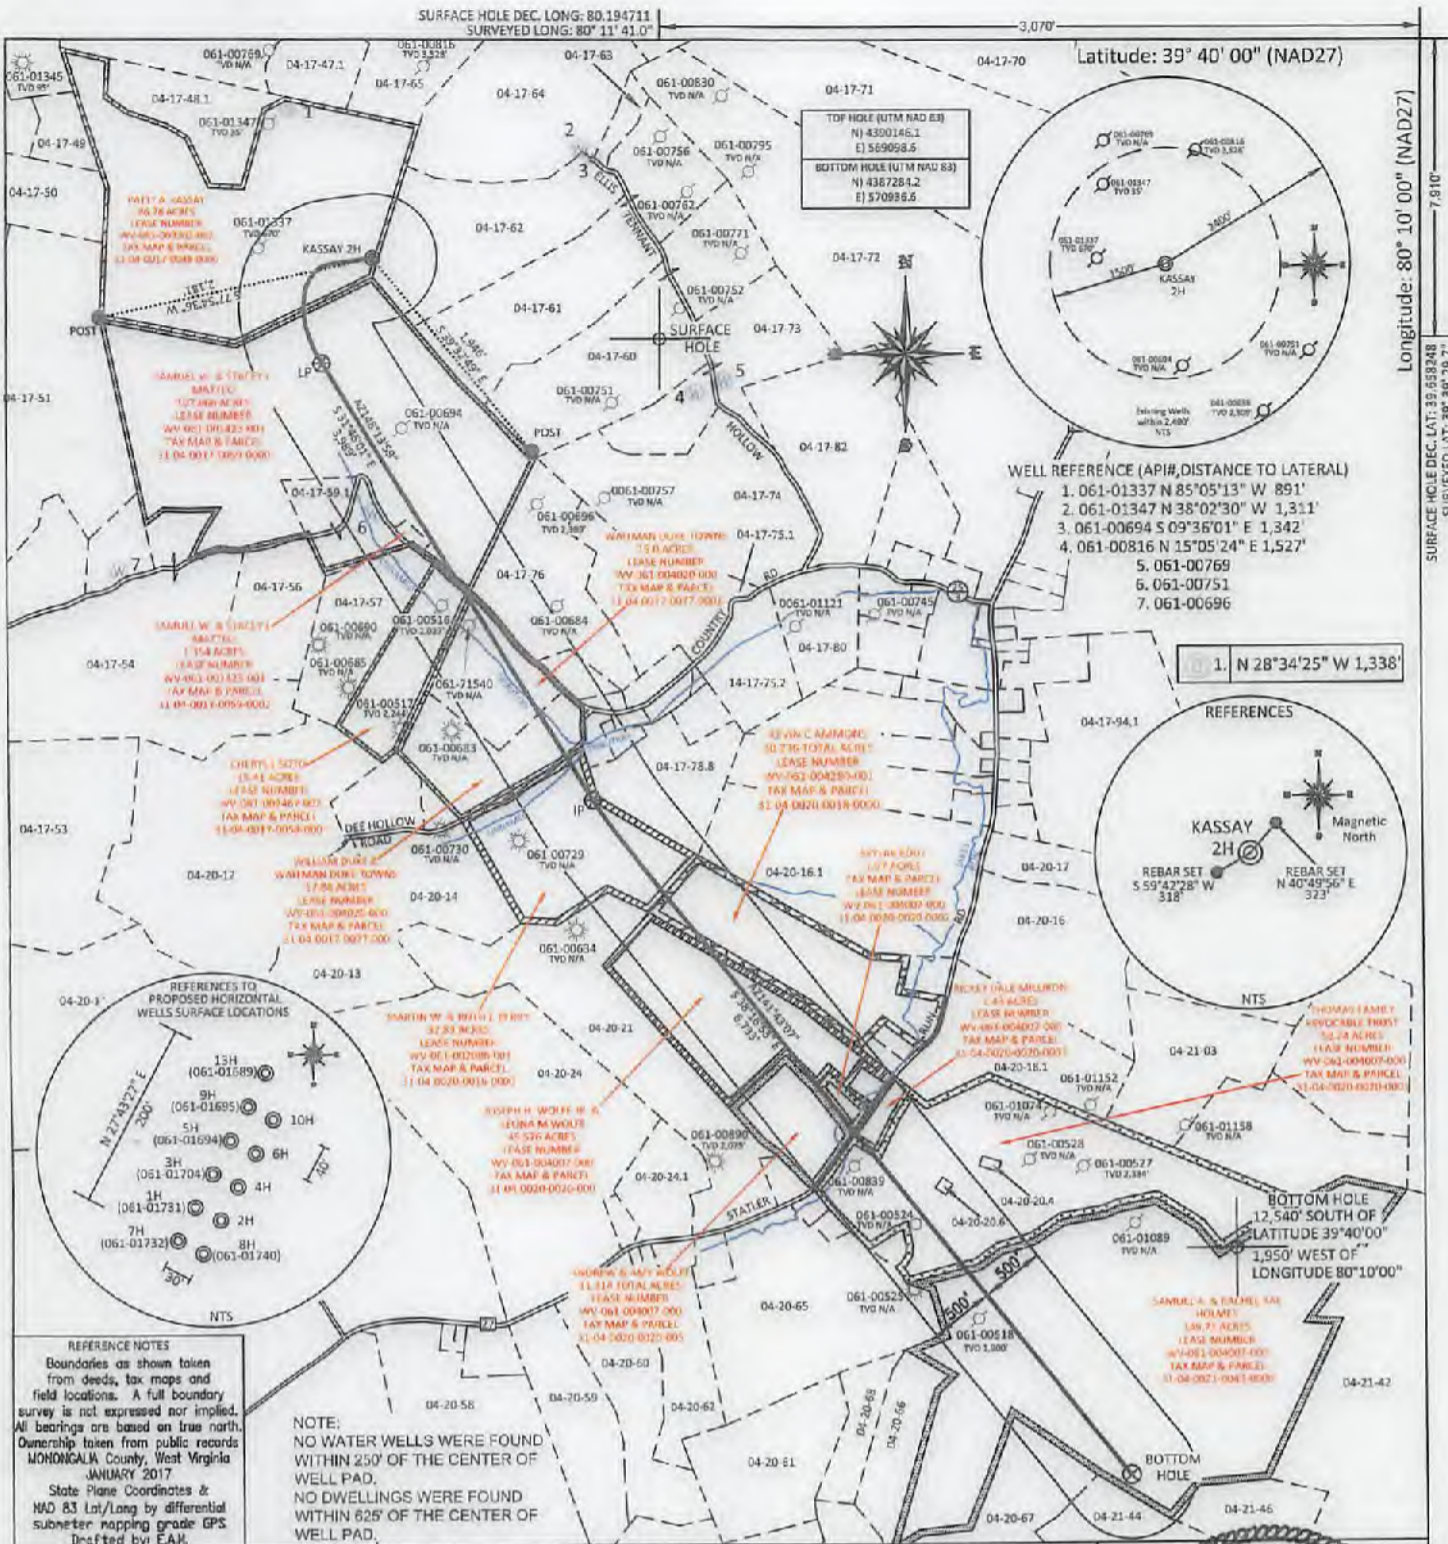



**REFERENCE NOTES**  
 Boundaries as shown taken from deeds, tax maps and field locations. A full boundary survey is not expressed nor implied. All bearings are based on true north. Ownership taken from public records MONONGALIA County, West Virginia JANUARY 2017  
 State Plane Coordinates & NAD 83 Lat/Long by differential submeter mapping grade GPS Drafted by E.A.H.

**NOTE:**  
 NO WATER WELLS WERE FOUND WITHIN 250' OF THE CENTER OF WELL PAD.  
 NO DWELLINGS WERE FOUND WITHIN 625' OF THE CENTER OF WELL PAD.

FILE #: NNE15  
 DRAWING #: 2817  
 SCALE: PLAT: 1" = 1500'  
 TICK: 1" = 2000'  
 MINIMUM DEGREE OF ACCURACY: 1/200  
 PROVEN SOURCE OF ELEVATION: SUBMETER MAPPING GRADE GPS

I, THE UNDERSIGNED, HEREBY CERTIFY THAT THIS PLAT IS CORRECT TO THE BEST OF MY KNOWLEDGE AND BELIEF AND SHOWS ALL THE INFORMATION REQUIRED BY LAW AND THE REGULATIONS ISSUED AND PRESCRIBED BY THE DEPARTMENT OF ENVIRONMENTAL PROTECTION.

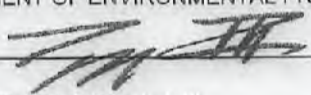Signed:   
 L.L.S. #2124 : Ernest J. Benchek III

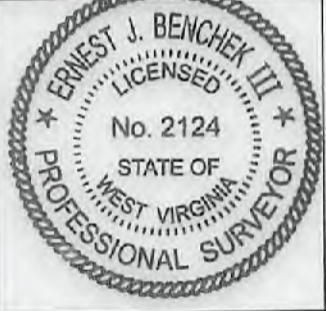

(+) DENOTES LOCATION OF WELL ON UNITED STATES TOPOGRAPHIC MAPS WVDEP  
 OFFICE OF OIL & GAS  
 601 57TH STREET  
 CHARLESTON, WV 25304

Well Type:  Oil  Waste Diposal  Production  Deep  
 Gas  Liquid Injection  Storage  Shallow

WATERSHED: DUNKARD CREEK  
 COUNTY/DISTRICT: MONONGALIA / CLAY  
 SURFACE OWNER: PATTY A. KASSAY  
 OIL & GAS ROYALTY OWNER: PATTY A. KASSAY  
 LEASE NUMBERS: \_\_\_\_\_

DATE: MARCH 5, 2018  
 OPERATOR'S WELL #: KASSAY 2H  
 API WELL #: 47 61 D1794  
 STATE COUNTY PERMIT

CURRENT ELEVATION: 1,534'  
 QUADRANGLE: BLACKSVILLE  
 ACREAGE: 86.78 +/-  
 ACREAGE: 576.866 +/-

DRILL  CONVERT  DRILL DEEPER  REDRILL  FRACTURE OR STIMULATE   
 PLUG OFF FORMATION  PERFORATE NEW FORMATION  PLUG & ABANDON   
 CLEAN OUT & REPLUG  OTHER CHANGE  (SPECIFY): \_\_\_\_\_

TARGET FORMATION: MARCELLUS  
 WELL OPERATOR: NORTHEAST NATURAL ENERGY LLC  
 ADDRESS: 707 VIRGINIA STREET EAST, SUITE 1200  
 CITY: CHARLESTON STATE: WV ZIP CODE: 25301

ESTIMATED DEPTH: TVD: 8,288' TMD: 19,628.04'  
 DESIGNATED AGENT: JOHN ADAMS  
 ADDRESS: 707 VIRGINIA STREET EAST, SUITE 1200  
 CITY: CHARLESTON STATE: WV ZIP CODE: 25301

**INFORMATION SUPPLIED UNDER WEST VIRGINIA CODE  
Chapter 22, Article 6A, Section 5(a)(5)  
IN LIEU OF FILING LEASE(S) AND OTHER CONTINUING CONTRACT(S)**

Under the oath required to make the verification on page 1 of this Notice and Application, I depose and say that I am the person who signed the Notice and Application for the Applicant, and that –

- (1) the tract of land is the same tract described in this Application, partly or wholly depicted in the accompanying plat, and described in the Construction and Reclamation Plan;
- (2) the parties and recordation data (if recorded) for lease(s) or other continuing contract(s) by which the Applicant claims the right to extract, produce or market the oil or gas are as follows:

Lease Name or Number	Grantor, Lessor, etc.	Grantee, Lessee, etc.	Royalty	Book/Page
Please See Attachment				

**Acknowledgement of Possible Permitting/Approval  
In Addition to the Office of Oil and Gas**

The permit applicant for the proposed well work addressed in this application hereby acknowledges the possibility of the need for permits and/or approvals from local, state, or federal entities in addition to the DEP, Office of Oil and Gas, including but not limited to the following:

- WV Division of Water and Waste Management
- WV Division of Natural Resources
- WV Division of Highways
- U.S. Army Corps of Engineers
- U.S. Fish and Wildlife Service
- County Floodplain Coordinator

The applicant further acknowledges that any Office of Oil and Gas permit in no way overrides, replaces, or nullifies the need for other permits/approvals that may be necessary and further affirms that all needed permits/approvals should be acquired from the appropriate authority before the affected activity is initiated.

Well Operator: Northeast Natural Energy LLC  
 By: Hollie M. Medley *Hollie M Medley*  
 Its: Regulatory Manager

RECEIVED  
 Office of Oil and Gas  
 MAR 16 2018  
 WV Department of Environmental Protection

WW-6A1	Operator's Well No.	KASSAY 2H		
NNE LEASE NUMBER	LESSOR NAME	LESSEE NAME	ROYALTY	BOOK/PAGE
WV-061-003302-002	Patty A. Kassay	Northeast Natural Energy LLC	0.125 OR GREATER	1506/143
WV-061-003654-001	Dorsey Neil Strickler And Nancy E. Strickler	Northeast Natural Energy LLC	DEED	1541/383
WV-061-003654-002	Lois Marie John, A Widow	Northeast Natural Energy LLC	DEED	1541/379
WV-061-003654-003	Paul T. Strickler And Sharon Strickler	Northeast Natural Energy LLC	DEED	1537/194
WV-061-003654-004	Mary Rose Butler	Northeast Natural Energy LLC	DEED	1537/198
WV-061-001423-001	Cathy Ann Collins	*Chesapeake Appalachia, LLC	0.125 OR GREATER	1377/172
WV-061-001423-002	Lula Haze Tennant Jones	*Chesapeake Appalachia, LLC	0.125 OR GREATER	1377/226
WV-061-001423-004	Betty Glover	*Chesapeake Appalachia, LLC	0.125 OR GREATER	1377/232
WV-061-001423-005	Shirley Tennant	*Chesapeake Appalachia, LLC	0.125 OR GREATER	1377/229
WV-061-001423-007	Jacob W Tennant And Elizabeth B Tennant	Northeast Natural Energy LLC	DEED	1524/196
WV-061-001423-008	Patricia Ellen Tennant Mayle	Northeast Natural Energy LLC	DEED	1585/833
WV-061-004382-001	Xto Energy Inc.	Northeast Natural Energy LLC	0.125 OR GREATER	1578/472
WV-061-003308-001	Chesapeake Appalachia Llc	*Chesapeake Appalachia Llc	0.125 OR GREATER	1487/224
WV-061-003308-002	Statoil Usa Onshore Properties	*Statoil Usa Onshore Properties Inc	0.125 OR GREATER	1488/721
WV-061-004249-001	Shuman Inc	Northeast Natural Energy Llc	0.125 OR GREATER	1568/775
WV-061-001423-007	Jacob W. Tennant And Elizabeth	Northeast Natural Energy LLC	DEED	1524/196
WV-061-001423-008	Patricia Ellen Tennant Mayle	Northeast Natural Energy LLC	DEED	1585/833
WV-061-001423-001	Cathy Ann Collins	Northeast Natural Energy LLC	0.125 OR GREATER	1578/472
WV-061-001423-002	Lula Haze Tennant Jones	Chesapeake Appalachia, LLC	0.125 OR GREATER	1377/172
WV-061-001423-003	Jacob W. Tennant	Chesapeake Appalachia, LLC	0.125 OR GREATER	1377/226
WV-061-001423-004	Betty Glover Aka Betty Ann Tennant	Chesapeake Appalachia, LLC	0.125 OR GREATER	1377/235
WV-061-001423-005	Shirley Tennant Aka Shirley A.	Chesapeake Appalachia, LLC	0.125 OR GREATER	1377/232
WV-061-001423-006	Patricia Ellen Tennant Mayle	Chesapeake Appalachia, LLC	0.125 OR GREATER	1377/229
WV-061-003308-002	Statoil Usa Onshore Properties	Chesapeake Appalachia, LLC	0.125 OR GREATER	1487/224
WV-061-004249-001	Shuman, Inc.	Northeast Natural Energy LLC	0.125 OR GREATER	1568/775
WV-061-004249-001	Shuman, Inc.	Northeast Natural Energy LLC	0.125 OR GREATER	1568/776
WV-061-004020-000	Mark V. and Betty A. Eddy	Northeast Natural Energy LLC	DEED	1505/572
WV-061-003908-001	Edgar James Wilson	Northeast Natural Energy LLC	DEED	1561/290
WV-061-003908-002	Arthur Gold	Northeast Natural Energy LLC	DEED	1561/334
WV-061-003908-003	Fred W Berdine Jr And Barbara Berdine	Northeast Natural Energy LLC	DEED	1563/554
WV-061-003908-004	Linda G Mashburn And John P Mashburn	Northeast Natural Energy LLC	DEED	15661/287
WV-061-003908-005	Mary Goff	Northeast Natural Energy LLC	DEED	1561/275
WV-061-003908-006	Eva Johnson And Richard E Johnson	Northeast Natural Energy LLC	DEED	1561/567
WV-061-003908-007	Joe Tanner	Northeast Natural Energy LLC	DEED	1561/694
WV-061-003908-008	Nelson Goff	Northeast Natural Energy LLC	DEED	1561/284
WV-061-003908-009	Forest H Goff	Northeast Natural Energy LLC	DEED	1561/281
WV-061-003908-010	Helen A Lambert	Northeast Natural Energy LLC	DEED	1561/166
WV-061-003908-011	Bonita F Hibbard	Northeast Natural Energy LLC	DEED	1567/185
WV-061-003908-012	Brenda A Haberle	Northeast Natural Energy LLC	DEED	1563/551
WV-061-003908-014	David M Herrington And Jacqueline K Herrington	Northeast Natural Energy LLC	DEED	1569/591
WV-061-004010-000	Albert Tennant	*Cj Ford	0.125 OR GREATER	27/16
WV-061-004010-001	Terri J Patterson And John L Patterson	Northeast Natural Energy LLC	DEED	1561/351
WV-061-004010-002	Debra Darlene Mcdaniels	Northeast Natural Energy LLC	DEED	1571/152
WV-061-004010-003	Baptist International Missions Inc	Northeast Natural Energy LLC	0.125 OR GREATER	1567/248
WV-061-004010-004	Mary Robin Buck And Gary A Buck	Northeast Natural Energy LLC	DEED	1571/143
WV-061-004010-008	Jesse E Berdine	Northeast Natural Energy LLC	DEED	1572/608
WV-061-004010-009	Margaret Lilian Berdine	Northeast Natural Energy LLC	DEED	1573/207
WV-061-004010-010	XTO Energy Inc.	Northeast Natural Energy LLC	0.125 OR GREATER	1578/477
WV-061-004169-001	Dwg Oil And Gas Acquisitions Llc	Northeast Natural Energy LLC	DEED	1570/133
WV-061-002467-002	Lindsay J. Tennant	Northeast Natural Energy LLC	0.125 OR GREATER	1421/389
WV-061-003906-001	Herbert Earl Hamilton And Cynthia Hamilton	Northeast Natural Energy LLC	0.125 OR GREATER	1562/511
WV-061-003906-002	Jessie Martin Tennant And Deborah K Tennant	Northeast Natural Energy LLC	0.125 OR GREATER	1559/279
WV-061-003906-003	Rosemary M Saunders And George D Saunders	Northeast Natural Energy LLC	0.125 OR GREATER	1563/148
WV-061-003906-004	Nancy Joe Wilson, Et Al	Northeast Natural Energy LLC	0.125 OR GREATER	1562/172
WV-061-003906-005	Georgia Ellen Tennant And Richard David Butcher Sr	Northeast Natural Energy LLC	0.125 OR GREATER	1568/305
WV-061-003906-006	Betty Louise Tennant	Northeast Natural Energy LLC	0.125 OR GREATER	1562/33
WV-061-003906-007	Moses Thomas Tennant	Northeast Natural Energy LLC	0.125 OR GREATER	1563/741
WV-061-003906-008	Robert D Kerns And Brenda Lee Kerns	Northeast Natural Energy LLC	0.125 OR GREATER	1564/208
WV-061-003906-009	Betty Sue Santee	Northeast Natural Energy LLC	0.125 OR GREATER	1564/198
WV-061-003969-001	Krista Burke	Northeast Natural Energy LLC	0.125 OR GREATER	1564/562

Office of Oil and Gas

MAR 16 2018

WV Department of

WV-061-003969-002	Maryann Raley	Northeast Natural Energy LLC	0.125 OR GREATER	1564/40
WV-061-003969-003	Steven Burl Britvec	Northeast Natural Energy LLC	0.125 OR GREATER	1562/414
WV-061-003969-004	David Marko And Amanda Marko	Northeast Natural Energy LLC	0.125 OR GREATER	1564/545
WV-061-003989-001	Barbara K Brookover	Northeast Natural Energy LLC	0.125 OR GREATER	1564/321
WV-061-004066-001	William L Tennant And Virginia Lee Tennant	Northeast Natural Energy LLC	0.125 OR GREATER	1563/773
WV-061-004066-002	Jessee Thomas Tennant Jr And Betty Tennant	Northeast Natural Energy LLC	0.125 OR GREATER	1563/83
WV-061-004066-003	Heather Tuttle	Northeast Natural Energy LLC	0.125 OR GREATER	1563/767
WV-061-004066-004	Matthew Ray Tennant	Northeast Natural Energy LLC	0.125 OR GREATER	1562/223
WV-061-004066-005	James Paul Rush	Northeast Natural Energy LLC	0.125 OR GREATER	1564/34
WV-061-004066-006	Brandi Leigh Hall Sanchez And Jamie Sanchez	Northeast Natural Energy LLC	0.125 OR GREATER	1564/145
WV-061-004066-007	Estate Of Lula Gail Britvec	Northeast Natural Energy LLC	0.125 OR GREATER	1564/130
WV-061-004069-001	David L Price And Susan Rose Price	Northeast Natural Energy LLC	0.125 OR GREATER	1561/52
WV-061-004302-001	Cheryl L Soto	Northeast Natural Energy LLC	0.125 OR GREATER	1572/784
WV-061-004382-001	Xto Energy Inc.	Northeast Natural Energy LLC	0.125 OR GREATER	1578/472
WV-061-002467-001	Jesse Thomas Tennant Jr	Northeast Natural Energy LLC	0.125 OR GREATER	1415/859
WV-061-002478-001	Frances H Hamilton, Et Al	Northeast Natural Energy LLC	0.125 OR GREATER	1439/307
WV-061-004020-000	Mark V. and Betty A. Eddy	Northeast Natural Energy LLC	DEED	1505/572
WV-061-003908-001	Edgar James Wilson	Northeast Natural Energy LLC	DEED	1561/290
WV-061-003908-002	Arthur Gold	Northeast Natural Energy LLC	DEED	1561/334
WV-061-003908-003	Fred W Berdine Jr And Barbara Berdine	Northeast Natural Energy LLC	DEED	1563/554
WV-061-003908-004	Linda G Mashburn And John P Mashburn	Northeast Natural Energy LLC	DEED	15661/287
WV-061-003908-005	Mary Goff	Northeast Natural Energy LLC	DEED	1561/275
WV-061-003908-006	Eva Johnson And Richard E Johnson	Northeast Natural Energy LLC	DEED	1561/567
WV-061-003908-007	Joe Tanner	Northeast Natural Energy LLC	DEED	1561/694
WV-061-003908-008	Nelson Goff	Northeast Natural Energy LLC	DEED	1561/284
WV-061-003908-009	Forest H Goff	Northeast Natural Energy LLC	DEED	1561/281
WV-061-003908-010	Helen A Lambert	Northeast Natural Energy LLC	DEED	1561/166
WV-061-003908-011	Bonita F Hibbard	Northeast Natural Energy LLC	DEED	1567/185
WV-061-003908-012	Brenda A Haberle	Northeast Natural Energy LLC	DEED	1563/551
WV-061-003908-014	David M Herrington And Jacqueline K Herrington	Northeast Natural Energy LLC	DEED	1569/591
WV-061-004010-000	Albert Tennant	CJ Ford	0.125 OR GREATER	27/16
WV-061-004010-001	Terri J Patterson And John L Patterson	Northeast Natural Energy LLC	DEED	1561/351
WV-061-004010-002	Debra Darlene Mcdaniels	Northeast Natural Energy LLC	DEED	1571/152
WV-061-004010-003	Baptist International Missions Inc	Northeast Natural Energy LLC	0.125 OR GREATER	1567/248
WV-061-004010-004	Mary Robin Buck And Gary A Buck	Northeast Natural Energy LLC	DEED	1571/143
WV-061-004010-008	Jesse E Berdine	Northeast Natural Energy LLC	DEED	1572/608
WV-061-004010-009	Margaret Lillian Berdine	Northeast Natural Energy LLC	DEED	1573/207
WV-061-004010-010	XTO Energy Inc.	Northeast Natural Energy LLC	0.125 OR GREATER	1578/477
WV-061-004169-001	Dwg Oil And Gas Acquisitions Llc	Northeast Natural Energy LLC	DEED	1570/133
WV-061-004280-001	Joy Smith	Northeast Natural Energy LLC	0.125 OR GREATER	1520/154
WV-061-004248-001	Piney Holdings, Inc.	Northeast Natural Energy LLC	0.125 OR GREATER	1568/777
WV-061-004249-001	Shuman, Inc.	Northeast Natural Energy LLC	0.125 OR GREATER	1568/775
WV-061-002088-001	Eleanor L Mcwhorter	*Chesapeake Appalachia, LLC	0.125 OR GREATER	1394/219
WV-061-002088-005	Danny D Tennant	*Chesapeake Appalachia, LLC	0.125 OR GREATER	1401/102
WV-061-002088-006	Pamela K Rowland	Northeast Natural Energy LLC	0.125 OR GREATER	1560/248
WV-061-002088-007	James P Eddy	Northeast Natural Energy LLC	0.125 OR GREATER	1567/685
WV-061-002088-008	Robert K Eddy	Northeast Natural Energy LLC	0.125 OR GREATER	1562/164
WV-061-002088-009	Carolyn Mccoy	Northeast Natural Energy LLC	0.125 OR GREATER	1567/540
WV-061-002088-010	Marilyn Edna Rhoades And James A Rhoades	Northeast Natural Energy LLC	0.125 OR GREATER	1571/818
WV-061-003864-001	John William Sprouse	Northeast Natural Energy LLC	0.125 OR GREATER	1553/621
WV-061-003864-002	Albert Johnston	Northeast Natural Energy LLC	0.125 OR GREATER	1552/774
WV-061-003864-003	Linda S Willis	Northeast Natural Energy LLC	DEED	1557/528
WV-061-003864-004	William Johnston And Barbara Johnston	Northeast Natural Energy LLC	0.125 OR GREATER	1562/47
WV-061-003864-005	Richard A Marlowe And Mari-Lisa Marlowe	Northeast Natural Energy LLC	0.125 OR GREATER	1562/45
WV-061-003864-006	John Calvin Michael And Shirley D Michael	Northeast Natural Energy LLC	0.125 OR GREATER	1563/735
WV-061-003864-007	Ramona Joan Shafer And Rodney D Shafer	Northeast Natural Energy LLC	0.125 OR GREATER	1564/687
WV-061-003864-008	Janice Marie Bondy	Northeast Natural Energy LLC	0.125 OR GREATER	1574/543
WV-061-003864-009	Lawrence R Berry And Cynthia M Berry	Northeast Natural Energy LLC	0.125 OR GREATER	1563/771
WV-061-003864-010	Darrell E Eddy And Almeida J Eddy	Northeast Natural Energy LLC	0.125 OR GREATER	1562/43
WV-061-003864-011	Betty E Michael Roy	Northeast Natural Energy LLC	0.125 OR GREATER	1560/306
WV-061-003864-012	Glenn G Eddy And Nina F Eddy	Northeast Natural Energy LLC	0.125 OR GREATER	1560/338
WV-061-003864-013	Robert Lee Ice II And Gwendolyn R Ice	Northeast Natural Energy LLC	0.125 OR GREATER	1564/366

MAR 16 2018

WV-061-003864-014	Marlene Tennant	Northeast Natural Energy LLC	0.125 OR GREATER	1591/210
WV-061-003864-015	Randy Yost And Joann Yost	Northeast Natural Energy LLC	0.125 OR GREATER	1564/28
WV-061-003864-016	David W Ice And Brenda Ice	Northeast Natural Energy LLC	0.125 OR GREATER	1564/46
WV-061-003864-017	Richard L Sprouse And Rose M Sprouse	Northeast Natural Energy LLC	0.125 OR GREATER	1562/39
WV-061-003864-018	Rhonda R Hullender And Edward B Hullender	Northeast Natural Energy LLC	0.125 OR GREATER	1563/725
WV-061-003864-019	Wayne Friend Eddy	Northeast Natural Energy LLC	0.125 OR GREATER	1562/37
WV-061-003864-020	Beulah Sue Masters	Northeast Natural Energy LLC	0.125 OR GREATER	1563/130
WV-061-003864-021	Charlotte Ann Ganoe King	Northeast Natural Energy LLC	0.125 OR GREATER	1563/737
WV-061-003864-022	Lola T Owen	Northeast Natural Energy LLC	0.125 OR GREATER	1563/93
WV-061-003864-023	Howard Lee Harris	Northeast Natural Energy LLC	0.125 OR GREATER	1564/637
WV-061-003864-024	Richard Arnold Harris And Sandra L Harris	Northeast Natural Energy LLC	DEED	1594/296
WV-061-003864-025	Billy Bales Ice	Northeast Natural Energy LLC	0.125 OR GREATER	1564/32
WV-061-003864-026	Robert Lee Eddy	Northeast Natural Energy LLC	0.125 OR GREATER	1563/739
WV-061-003864-027	Faith Ann Reesman	Northeast Natural Energy LLC	0.125 OR GREATER	1563/761
WV-061-003864-028	John J Tokarz And Brenda Tokarz	Northeast Natural Energy LLC	DEED	1579/833
WV-061-003864-029	Mary Ann Tokarz And Mary L Deaner	Northeast Natural Energy LLC	DEED	1579/836
WV-061-003864-030	Alice Marie Lemley	Northeast Natural Energy LLC	0.125 OR GREATER	1564/202
WV-061-003864-031	Gary L Ice	Northeast Natural Energy LLC	0.125 OR GREATER	1562/35
WV-061-003864-032	Rebecca Jean Bright	Northeast Natural Energy LLC	DEED	1592/347
WV-061-003864-033	Carolyn Sue Tokarz	Northeast Natural Energy LLC	DEED	1588/649
WV-061-003864-035	Barbara A Reynolds And Marc S Reynolds	Northeast Natural Energy LLC	0.125 OR GREATER	1564/681
WV-061-003864-036	Larry M Eddy And Nancy L Eddy	Northeast Natural Energy LLC	0.125 OR GREATER	1564/691
WV-061-003864-037	Linda S Slaughter	Northeast Natural Energy LLC	0.125 OR GREATER	1563/138
WV-061-003864-038	Patricia A Lewis	Northeast Natural Energy LLC	0.125 OR GREATER	1560/310
WV-061-003864-039	Connie L Jones	Northeast Natural Energy LLC	0.125 OR GREATER	1564/697
WV-061-003864-040	Vina J Ice An DPhillip Kalisz	Northeast Natural Energy LLC	0.125 OR GREATER	1564/217
WV-061-003864-041	Alberet K Griffith Family Trust	Northeast Natural Energy LLC	0.125 OR GREATER	1567/538
WV-061-003973-001	Connie L Jones	Northeast Natural Energy LLC	0.125 OR GREATER	1564/675
WV-061-003973-002	Linda S Slaughter	Northeast Natural Energy LLC	0.125 OR GREATER	1564/206
WV-061-003973-003	Patricia A Lewis	Northeast Natural Energy LLC	0.125 OR GREATER	1563/769
WV-061-004147-001	New Augusta Inc	Northeast Natural Energy LLC	0.125 OR GREATER	1565/769
WV-061-004147-002	Mark Eddy	Northeast Natural Energy LLC	0.125 OR GREATER	1565/767
WV-061-003970-001	Debra Ann Huggins Cosgrove	Northeast Natural Energy LLC	0.125 OR GREATER	1564/683
WV-061-003970-002	James Joseph Smiley Jr	Northeast Natural Energy LLC	DEED	1570/119
WV-061-003970-003	Richard John Smiley	Northeast Natural Energy LLC	DEED	1570/119
WV-061-003970-004	Sheila A Romel	Northeast Natural Energy LLC	0.125 OR GREATER	1562/31
WV-061-003970-005	Tanya E Riley	Northeast Natural Energy LLC	0.125 OR GREATER	1565/455
WV-061-003970-006	Ernest Lee Mccall li	Northeast Natural Energy LLC	0.125 OR GREATER	1562/29
WV-061-003970-007	Tarla Lee Mccall	Northeast Natural Energy LLC	0.125 OR GREATER	1563/765
WV-061-003970-008	John Olen Cross Jr	Northeast Natural Energy LLC	0.125 OR GREATER	1564/194
WV-061-003970-009	Stanley Eugene Albaugh	Northeast Natural Energy LLC	0.125 OR GREATER	1560/90
WV-061-003970-010	Patricia A Richards	Northeast Natural Energy LLC	0.125 OR GREATER	1564/221
WV-061-003970-011	Susan L Wilsom	Northeast Natural Energy LLC	0.125 OR GREATER	1564/234
WV-061-003970-012	Charles Edward Cross	Northeast Natural Energy LLC	0.125 OR GREATER	1563/132
WV-061-003970-013	Robert Lee Harris	Northeast Natural Energy LLC	0.125 OR GREATER	1563/420
WV-061-003970-014	Mary L Garten	Northeast Natural Energy LLC	0.125 OR GREATER	1562/158
WV-061-003970-015	Trena M Smith	Northeast Natural Energy LLC	0.125 OR GREATER	1563/733
WV-061-003970-016	Phyllis S Wilson	Northeast Natural Energy LLC	0.125 OR GREATER	1563/751
WV-061-003970-017	Willard Anthony Wright	Northeast Natural Energy LLC	0.125 OR GREATER	1563/813
WV-061-003970-018	April D Boring	Northeast Natural Energy LLC	0.125 OR GREATER	1563/134
WV-061-003970-019	Bradford Scott Cornwell	Northeast Natural Energy LLC	0.125 OR GREATER	1568/293
WV-061-003970-020	Earl S Vanantwerp	Northeast Natural Energy LLC	0.125 OR GREATER	1585/260
WV-061-003970-021	David A Vanantwerp	Northeast Natural Energy LLC	0.125 OR GREATER	1585/262
WV-061-003970-022	Donna Lynch Huggins Hackworth	Northeast Natural Energy LLC	0.125 OR GREATER	1589/255
WV-061-003970-023	Margie Rinehart	Northeast Natural Energy LLC	0.125 OR GREATER	1564/204
WV-061-003970-024	Mary Ellen Hugus	Northeast Natural Energy LLC	0.125 OR GREATER	1566/231
WV-061-003970-025	Rosemarie Phillips	Northeast Natural Energy LLC	0.125 OR GREATER	1561/54
WV-061-003970-026	Leslie Edmonds	Northeast Natural Energy LLC	0.125 OR GREATER	1563/85
WV-061-003970-027	Clarke Randolph Cornwell	Northeast Natural Energy LLC	0.125 OR GREATER	1568/436
WV-061-003970-028	Patricia Jane Thiemrodt	Northeast Natural Energy LLC	DEED	1561/570
WV-061-003970-029	Emily Kay Shrock	Northeast Natural Energy LLC	DEED	1561/573
WV-061-003970-030	Matthew W Blake	Northeast Natural Energy LLC	0.125 OR GREATER	1567/662

RECEIVED  
Office of Oil and Gas

MAR 16 2018

4706101794

WV-061-003970-031	Randy A Fisher	Northeast Natural Energy LLC	0.125 OR GREATER	1566/210
WV-061-003970-032	Roberta J Miller	Northeast Natural Energy LLC	0.125 OR GREATER	1566/208
WV-061-003970-033	Richard K Fisher And Joy L Fisher	Northeast Natural Energy LLC	0.125 OR GREATER	1566/126
WV-061-003970-034	Victoria Lee Burns And Dale J Burns	Northeast Natural Energy LLC	0.125 OR GREATER	1568/121
WV-061-003970-035	Cynthia Harris	Northeast Natural Energy LLC	DEED	1569/574
WV-061-003970-036	Sharon L Mount	Northeast Natural Energy LLC	0.125 OR GREATER	1571/814
WV-061-003970-037	Jackie Lee Jones Jr	Northeast Natural Energy LLC	0.125 OR GREATER	1571/816
WV-061-003970-038	Melissa Wilson	Northeast Natural Energy LLC	0.125 OR GREATER	1572/838
WV-061-003970-039	Francis Adam Szymanski	Northeast Natural Energy LLC	0.125 OR GREATER	1571/820
WV-061-003970-040	Daniel J Szymanski	Northeast Natural Energy LLC	0.125 OR GREATER	1571/822
WV-061-003970-041	Elizabeth Victoria Snyder Tinney	Northeast Natural Energy LLC	0.125 OR GREATER	1571/824
WV-061-003970-042	Annetta Marie Garrett	Northeast Natural Energy LLC	0.125 OR GREATER	1575/280
WV-061-003970-043	Georgia Mary Harris Dibernardo	Northeast Natural Energy LLC	0.125 OR GREATER	
WV-061-003970-044	Kathy Lynn Tragesser	Northeast Natural Energy LLC	0.125 OR GREATER	1580/560
WV-061-003980-001	Steven Allen Albaugh	Northeast Natural Energy LLC	0.125 OR GREATER	1560/90
WV-061-004062-001	Martin W Berry And Ruth J Berry	Northeast Natural Energy LLC	0.125 OR GREATER	1563/755
WV-061-004382-001	Xto Energy Inc.	Northeast Natural Energy LLC	0.125 OR GREATER	1578/472
WV-061-004062-001	Martin W Berry And Ruth J Berry	Northeast Natural Energy LLC	0.125 OR GREATER	1563/755
WV-061-004382-001	Xto Energy Inc.	Northeast Natural Energy LLC	0.125 OR GREATER	1578/472
WV-061-004314-001	Reed Energy Services Inc	Northeast Natural Energy LLC	DEED	1580/200
WV-061-004382-001	Xto Energy Inc.	Northeast Natural Energy LLC	0.125 OR GREATER	1578/472
WV-061-004007-000	Nimrod A. Tennant And Margaret J. Tennant	Dewitt, Ira	0.125 OR GREATER	26/359
WV-061-004007-000	Nimrod A. Tennant And Margaret J. Tennant	Dewitt, Ira	0.125 OR GREATER	26/359
WV-061-004007-000	Nimrod A. Tennant And Margaret J. Tennant	Dewitt, Ira	0.125 OR GREATER	26/359
WV-061-004007-000	Nimrod A. Tennant And Margaret J. Tennant	Dewitt, Ira	0.125 OR GREATER	26/359
WV-061-004007-000	Nimrod A. Tennant And Margaret J. Tennant	Dewitt, Ira	0.125 OR GREATER	26/359
WV-061-004007-000	Nimrod A. Tennant And Margaret	Dewitt, Ira	0.125 OR GREATER	26/359
WV-061-003721-001	Mary D. Fluharty And Roger Fluharty	Northeast Natural Energy LLC	DEED	1561/563
WV-061-003721-002	Eugene Armstrong	Northeast Natural Energy LLC	DEED	1557/170
WV-061-003721-003	Judith Williams	Northeast Natural Energy LLC	DEED	1559/795
WV-061-003721-004	Monica Miller	Northeast Natural Energy LLC	DEED	1560/579
WV-061-003721-005	David B. Tennant And Patricia J. Tennant	Northeast Natural Energy LLC	DEED	1560/384
WV-061-003721-006	Clifton E. Tennant And Loretta	Northeast Natural Energy LLC	DEED	1560/392
WV-061-003721-007	Olan W. Tennant	Northeast Natural Energy LLC	DEED	1560/392
WV-061-003721-008	Wilma G. Williams	Northeast Natural Energy LLC	DEED	1560/388
WV-061-003721-009	Denzil C. Wilson	Northeast Natural Energy LLC	DEED	1560/380
WV-061-003721-010	Martha Peters	Northeast Natural Energy LLC	DEED	1560/337
WV-061-003721-011	Kathy Brown	Northeast Natural Energy LLC	DEED	1561/559
WV-061-003721-012	Sara Beth Hensley And Ronald H	Northeast Natural Energy LLC	DEED	1561/555
WV-061-003721-013	Betty L. Vandetta	Northeast Natural Energy LLC	DEED	1557/247
WV-061-003721-014	Connie S. Wolfe	Northeast Natural Energy LLC	DEED	1557/243
WV-061-003721-015	Ronald D. Walls And Sue Walls	Northeast Natural Energy LLC	DEED	1557/239
WV-061-003721-016	Joyce E. Walls	Northeast Natural Energy LLC	DEED	1560/784
WV-061-003721-017	Melvin Carl Williams And Jean A. Williams	Northeast Natural Energy LLC	DEED	1559/439
WV-061-003721-018	Terri Ann Marratta	Northeast Natural Energy LLC	DEED	1561/323
WV-061-003721-019	Virginia Ellen Stiles	Northeast Natural Energy LLC	DEED	1561/209
WV-061-003721-020	Dortohy Jean Johns	Northeast Natural Energy LLC	DEED	1570/119
WV-061-003721-021	Mary Margaret Headlee	Northeast Natural Energy LLC	DEED	1570/119
WV-061-003721-022	David S. Bracken And Jane A. Bracken	Northeast Natural Energy LLC	DEED	1570/119
WV-061-003721-023	Linda M. Tennant	Northeast Natural Energy LLC	DEED	1570/119
WV-061-003721-024	Timonthy Alan Walls And Jennifer	Northeast Natural Energy LLC	DEED	1570/119
WV-061-003721-025	Johnny Eugene Williams	Northeast Natural Energy LLC	DEED	1570/119
WV-061-003721-026	John Vernon Williams And Catha	Northeast Natural Energy LLC	DEED	1570/119
WV-061-003721-027	William Raymond Swick, Jr.	Northeast Natural Energy LLC	DEED	1570/119
WV-061-003721-028	Krishnan R. Lannen	Northeast Natural Energy LLC	DEED	1570/119
WV-061-003721-030	Jane Ann Jones	Northeast Natural Energy LLC	DEED	1578/132
WV-061-003721-031	Heather M. Lannen	Northeast Natural Energy LLC	DEED	1596/445
WV-061-003721-032	David Colwell Gallatin	Northeast Natural Energy LLC	DEED	1570/119
WV-061-003721-033	Patricia A. Whitehead	Northeast Natural Energy LLC	DEED	1570/119
WV-061-003721-034	Gary W. Tennant	Northeast Natural Energy LLC	DEED	1570/119
WV-061-003721-035	Douglas W. Tennant And Barbara	Northeast Natural Energy LLC	DEED	1570/119
WV-061-003721-036	Deborah L. Hill	Northeast Natural Energy LLC	DEED	1570/119

1570/119 DEED  
Office of Oil and Gas

MAR 16 2018

WV Department of  
Environmental Protection

4706101794

WV-061-003721-037	Gregory L. Tennant	Northeast Natural Energy LLC	DEED	1570/119
WV-061-003721-038	Barbara A. Bonnell, Aka Barbara A. Tennant	Northeast Natural Energy LLC	DEED	1570/119
WV-061-003721-040	Susan R. Edwards And David Edwards	Northeast Natural Energy LLC	DEED	1570/119
WV-061-003721-041	Linda L. Barker And William H. Baker Sr.	Northeast Natural Energy LLC	DEED	1570/119
WV-061-003721-042	Steven Richard Freeland And Manami Fukuda Freeland	Northeast Natural Energy LLC	DEED	1578/132
WV-061-003721-043	Daryl Glenn Gallatin And Kristine M. Gallatin	Northeast Natural Energy LLC	DEED	1570/119
WV-061-003721-044	James Earl Cooper	Northeast Natural Energy LLC	DEED	1570/119
WV-061-003721-045	Robert D. Gump, Jr. And Kelly S. Gump	Northeast Natural Energy LLC	DEED	1570/119
WV-061-003721-046	Chantal Kay Freeland	Northeast Natural Energy LLC	DEED	1570/119
WV-061-003721-047	David R. Tennant, Jr.	Northeast Natural Energy LLC	DEED	1570/119
WV-061-003721-048	Sybil Larita Tennant	Northeast Natural Energy LLC	DEED	1570/119
WV-061-003721-049	Shelia Anderson-Freeland	Northeast Natural Energy LLC	DEED	1578/132
WV-061-003721-050	Donna Luketic And Donald Luketic	Northeast Natural Energy LLC	DEED	1569/567
WV-061-003721-052	Richard Joseph Wilson	Northeast Natural Energy LLC	DEED	1570/119
WV-061-003721-053	Carol M. Standifrod And Grant W. Standford	Northeast Natural Energy LLC	DEED	1577/12
WV-061-003721-054	Thomas A. Morris	Northeast Natural Energy LLC	0.125 OR GREATER	1595/763
WV-061-003721-029	Mary Catherine Walls	Northeast Natural Energy LLC	0.125 OR GREATER	1563/753

RECEIVED  
Office of Oil and Gas

MAR 16 2018

WV Department of  
Environmental Protection

4706101794

Chesapeake Appalachia, LLC.



Northeast Natural Energy  
Assignment  
BK 120/769

RECEIVED  
Office of Oil and Gas

MAR 16 2018

WV Department of  
Environmental Protection



4706101794

Chesapeake Appalachia, LLC.  
And  
Statoil USA Onshore Properties Inc.

Northeast Natural Energy  
Assignment  
BK 120/769

RECEIVED  
Office of Oil and Gas

MAR 16 2018

WV Department of  
Environmental Protection

4706101794

C. J. Ford (Charles J. Ford)

South Penn Oil Company  
Assignment  
DB 27/287  
South Penn Oil Company

South Penn Natural Gas Company  
Assignment  
DB 304/457  
South Penn Natural Gas Company

South Penn Oil Company  
Deed  
DB 580/311  
Pennzoil Company

New Dunstan, Inc.  
Assignment  
AB 20/484  
New Dunstan, Inc.

Pennzoil Company & Pennzoil Producing  
Deed  
DB 210/611  
Pennzoil Company & Pennzoil Production

Pennzoil Products Company  
Assignment  
AR 23/280  
Pennzoil Products Company


Eddy Brothers (Mark V. Eddy & Harry Eddy)  
Assignment  
DB 1063/553  
Eddy Brothers (Mark V. Eddy & Harry Eddy)

NNE Resources, LLC  
Assignment  
AB 123/370

RECEIVED  
Office of Oil and Gas

MAR 16 2018

WV Department of  
Environmental Protection

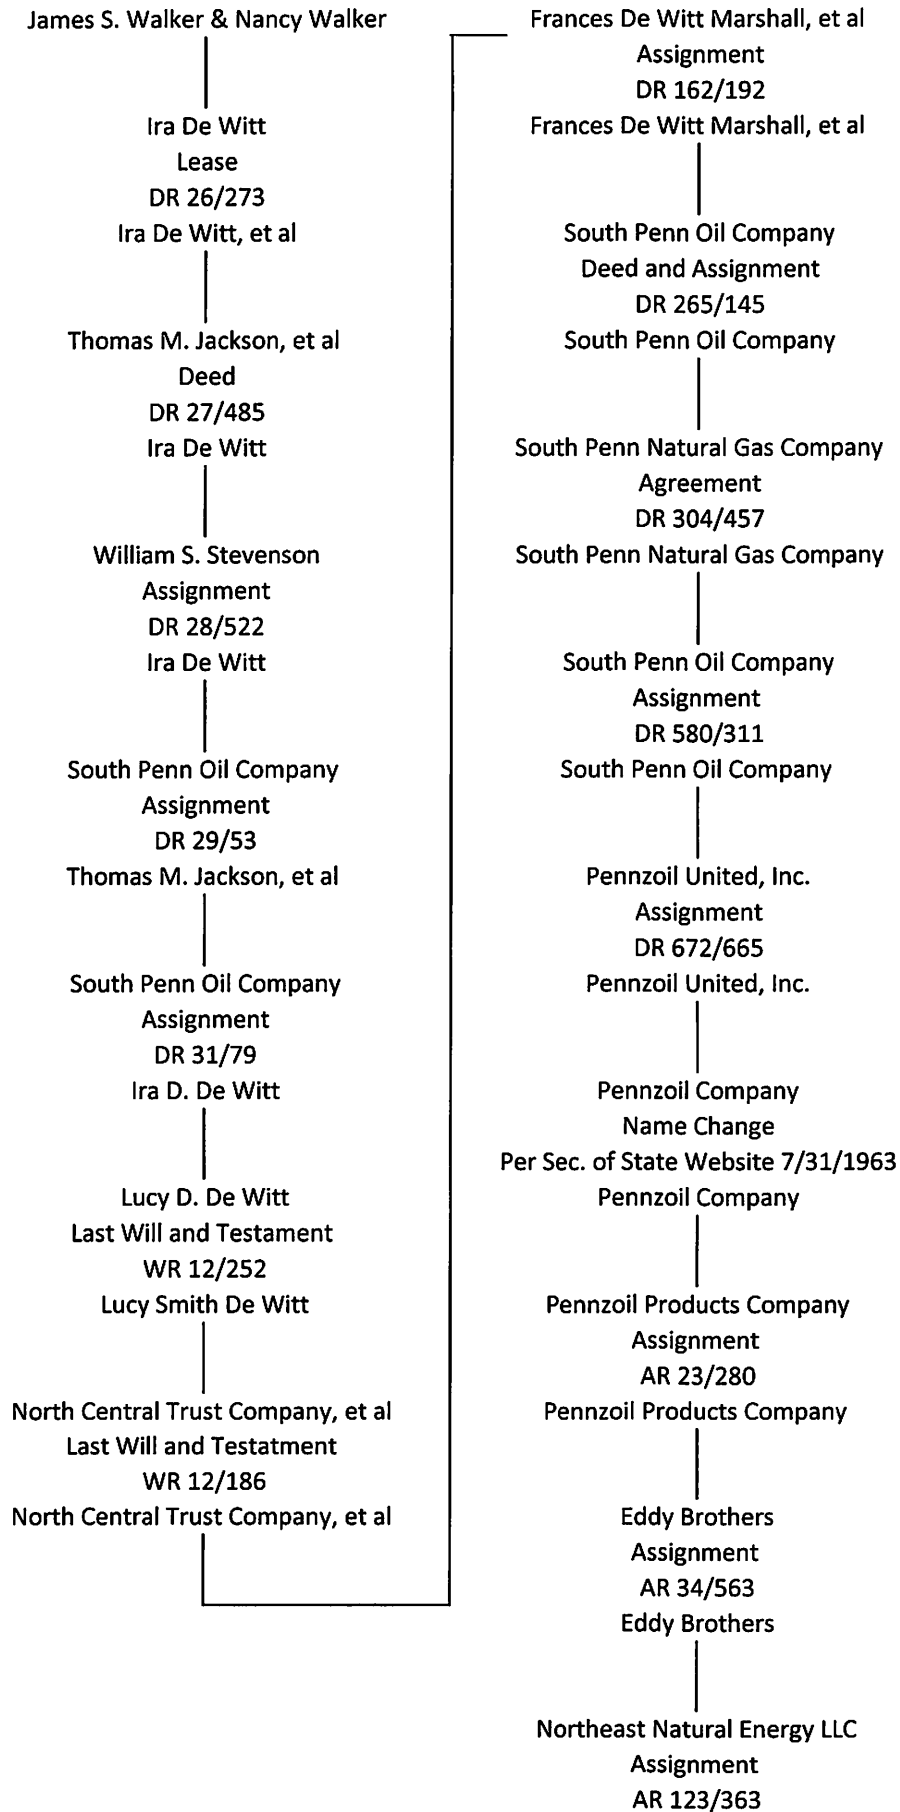

RECEIVED  
Office of Oil and Gas

MAR 16 2018

WV Department of  
Environmental Protection



4706101794

November 15, 2017

WV Department of Environmental Protection  
Office of Oil and Gas Management  
601 57<sup>th</sup> Street, SE  
Charleston, West Virginia 25304

RE: Kassay 2H and 4H

Dear Permit Reviewer:

Please be advised that Northeast Natural Energy LLC has the right to drill, extract and produce the minerals beneath the roads identified as Statler Run Road (State Route 27), Country Road (State Route 25/3), and Dee Hollow Road (State Route 919) on the enclosed survey plat.

Sincerely,

A handwritten signature in blue ink that reads 'Jeannie Morgan Johnson'.

Jeannie Morgan Johnson, CPL  
Vice President – Land Operations

Enclosure

STATE OF WEST VIRGINIA  
DEPARTMENT OF ENVIRONMENTAL PROTECTION, OFFICE OF OIL AND GAS  
NOTICE CERTIFICATION

Date of Notice Certification: 11/20/2017

API No. 47- \_\_\_\_\_  
Operator's Well No. Kassay 2H  
Well Pad Name: Kassay

Notice has been given:

Pursuant to the provisions in West Virginia Code § 22-6A, the Operator has provided the required parties with the Notice Forms listed below for the tract of land as follows:

State: West Virginia	UTM NAD 83	Easting: 569098.6
County: Monongalia		Northing: 4390146.1
District: Clay	Public Road Access:	County Route 25/3 (Yank Hollow Road)
Quadrangle: Blacksville	Generally used farm name:	Kassay
Watershed: Dunkard Creek		

Pursuant to West Virginia Code § 22-6A-7(b), every permit application filed under this section shall be on a form as may be prescribed by the secretary, shall be verified and shall contain the following information: (14) A certification from the operator that (i) it has provided the owners of the surface described in subdivisions (1), (2) and (4), subsection (b), section ten of this article, the information required by subsections (b) and (c), section sixteen of this article; (ii) that the requirement was deemed satisfied as a result of giving the surface owner notice of entry to survey pursuant to subsection (a), section ten of this article six-a; or (iii) the notice requirements of subsection (b), section sixteen of this article were waived in writing by the surface owner; and Pursuant to West Virginia Code § 22-6A-11(b), the applicant shall tender proof of and certify to the secretary that the notice requirements of section ten of this article have been completed by the applicant.

<p>Pursuant to West Virginia Code § 22-6A, the Operator has attached proof to this Notice Certification that the Operator has properly served the required parties with the following:</p> <p>*PLEASE CHECK ALL THAT APPLY</p> <p><input type="checkbox"/> 1. NOTICE OF SEISMIC ACTIVITY or <input checked="" type="checkbox"/> NOTICE NOT REQUIRED BECAUSE NO SEISMIC ACTIVITY WAS CONDUCTED</p> <p><input checked="" type="checkbox"/> 2. NOTICE OF ENTRY FOR PLAT SURVEY or <input type="checkbox"/> NO PLAT SURVEY WAS CONDUCTED</p> <p><input checked="" type="checkbox"/> 3. NOTICE OF INTENT TO DRILL or <input type="checkbox"/> NOTICE NOT REQUIRED BECAUSE NOTICE OF ENTRY FOR PLAT SURVEY WAS CONDUCTED or</p> <p><input type="checkbox"/> WRITTEN WAIVER BY SURFACE OWNER (PLEASE ATTACH)</p> <p><input checked="" type="checkbox"/> 4. NOTICE OF PLANNED OPERATION</p> <p><input checked="" type="checkbox"/> 5. PUBLIC NOTICE</p> <p><input checked="" type="checkbox"/> 6. NOTICE OF APPLICATION</p>	<p><b>OOG OFFICE USE ONLY</b></p> <p><input type="checkbox"/> RECEIVED/ NOT REQUIRED</p> <p><input checked="" type="checkbox"/> RECEIVED</p> <p><input checked="" type="checkbox"/> RECEIVED/ NOT REQUIRED</p> <p><input checked="" type="checkbox"/> RECEIVED</p> <p><input checked="" type="checkbox"/> RECEIVED</p> <p><input checked="" type="checkbox"/> RECEIVED</p>
---	--

Required Attachments:

The Operator shall attach to this Notice Certification Form all Notice Forms and Certifications of Notice that have been provided to the required parties and/or any associated written waivers. For the Public Notice, the operator shall attach a copy of the Class II Legal Advertisement with publication date verification or the associated Affidavit of Publication. The attached Notice Forms and Certifications of Notice shall serve as proof that the required parties have been noticed as required under West Virginia Code § 22-6A. Pursuant to West Virginia Code § 22-6A-11(b), the Certification of Notice to the person may be made by affidavit of personal service, the return receipt card or other postal receipt for certified mailing.

RECEIVED  
Office of Oil and Gas  
NOV 22 2017  
WV Department of  
Environmental Protection

**Certification of Notice is hereby given:**

THEREFORE, I Hollie M. Medley, have read and understand the notice requirements within West Virginia Code § 22-6A. I certify that as required under West Virginia Code § 22-6A, I have served the attached copies of the Notice Forms, identified above, to the required parties through personal service, by registered mail or by any method of delivery that requires a receipt or signature confirmation. I certify under penalty of law that I have personally examined and am familiar with the information submitted in this Notice Certification and all attachments, and that based on my inquiry of those individuals immediately responsible for obtaining the information, I believe that the information is true, accurate and complete. I am aware that there are significant penalties for submitting false information, including the possibility of fine and imprisonment.

Well Operator:	<u>Northeast Natural Energy LLC</u>	Address:	<u>707 Virginia Street East, Suite 1200</u>
By:	<u>Hollie M. Medley</u>		<u>Charleston, WV 25301</u>
Its:	<u>Regulatory Manager</u>	Facsimile:	<u>304-241-5972</u>
Telephone:	<u>304-212-0422</u>	Email:	<u>hmedley@nne-lc.com</u>



*Hollie M. Medley*  
 Subscribed and sworn before me this 21 day of November, 2017.  
*Christalle Patton* Notary Public  
 My Commission Expires June 18, 2018

**Oil and Gas Privacy Notice**

The Office of Oil and Gas processes your personal information, such as name, address and telephone number, as part of our regulatory duties. Your personal information may be disclosed to other State agencies or third parties in the normal course of business or as needed to comply with statutory or regulatory requirements, including Freedom of Information Act requests. Our office will appropriately secure your personal information. If you have any questions about our use or your personal information, please contact DEP's Chief Privacy Officer at [depprivacyofficer@wv.gov](mailto:depprivacyofficer@wv.gov).

RECEIVED  
 Office of Oil and Gas  
 NOV 22 2017  
 WV Department of  
 Environmental Protection

STATE OF WEST VIRGINIA  
DEPARTMENT OF ENVIRONMENTAL PROTECTION, OFFICE OF OIL AND GAS  
NOTICE OF APPLICATION

Notice Time Requirement: notice shall be provided no later than the filing date of permit application.

Date of Notice: 11/9/2017 Date Permit Application Filed: 11/20/2017

Notice of:

- PERMIT FOR ANY WELL WORK
- CERTIFICATE OF APPROVAL FOR THE CONSTRUCTION OF AN IMPOUNDMENT OR PIT

Delivery method pursuant to West Virginia Code § 22-6A-10(b)

- PERSONAL SERVICE
- REGISTERED MAIL
- METHOD OF DELIVERY THAT REQUIRES A RECEIPT OR SIGNATURE CONFIRMATION

Pursuant to W. Va. Code § 22-6A-10(b) no later than the filing date of the application, the applicant for a permit for any well work or for a certificate of approval for the construction of an impoundment or pit as required by this article shall deliver, by personal service or by registered mail or by any method of delivery that requires a receipt or signature confirmation, copies of the application, the erosion and sediment control plan required by section seven of this article, and the well plat to each of the following persons: (1) The owners of record of the surface of the tract on which the well is or is proposed to be located; (2) The owners of record of the surface tract or tracts overlying the oil and gas leasehold being developed by the proposed well work, if the surface tract is to be used for roads or other land disturbance as described in the erosion and sediment control plan submitted pursuant to subsection (c), section seven of this article; (3) The coal owner, operator or lessee, in the event the tract of land on which the well proposed to be drilled is located [sic] is known to be underlain by one or more coal seams; (4) The owners of record of the surface tract or tracts overlying the oil and gas leasehold being developed by the proposed well work, if the surface tract is to be used for the placement, construction, enlargement, alteration, repair, removal or abandonment of any impoundment or pit as described in section nine of this article; (5) Any surface owner or water purveyor who is known to the applicant to have a water well, spring or water supply source located within one thousand five hundred feet of the center of the well pad which is used to provide water for consumption by humans or domestic animals; and (6) The operator of any natural gas storage field within which the proposed well work activity is to take place. (c)(1) If more than three tenants in common or other co-owners of interests described in subsection (b) of this section hold interests in the lands, the applicant may serve the documents required upon the person described in the records of the sheriff required to be maintained pursuant to section eight, article one, chapter eleven-a of this code. (2) Notwithstanding any provision of this article to the contrary, notice to a lien holder is not notice to a landowner, unless the lien holder is the landowner. W. Va. Code R. § 35-8-5.7.a requires, in part, that the operator shall also provide the Well Site Safety Plan ("WSSP") to the surface owner and any water purveyor or surface owner subject to notice and water testing as provided in section 15 of this rule.

Application Notice  WSSP Notice  E&S Plan Notice  Well Plat Notice is hereby provided to:

SURFACE OWNER(s)

Name: See Attachment  
Address: \_\_\_\_\_

Name: \_\_\_\_\_  
Address: \_\_\_\_\_

SURFACE OWNER(s) (Road and/or Other Disturbance)

Name: See Attachment  
Address: \_\_\_\_\_

Name: \_\_\_\_\_  
Address: \_\_\_\_\_

SURFACE OWNER(s) (Impoundments or Pits)

Name: \_\_\_\_\_  
Address: \_\_\_\_\_

COAL OWNER OR LESSEE

Name: See Attachment  
Address: \_\_\_\_\_

COAL OPERATOR

Name: \_\_\_\_\_  
Address: \_\_\_\_\_

SURFACE OWNER OF WATER WELL AND/OR WATER PURVEYOR(s)

Name: See Attachment  
Address: \_\_\_\_\_

OPERATOR OF ANY NATURAL GAS STORAGE FIELD

Name: \_\_\_\_\_  
Address: \_\_\_\_\_

\*Please attach additional forms if necessary

RECEIVED  
Office of Oil and Gas

NOV 22 2017

WV Department of  
Environmental Protection

WW-6A  
(8-13)

NOV 22 2017

API NO. 47- \_\_\_\_\_  
OPERATOR WELL NO. Kassey 2H  
Well Pad Name: KasseyWV Department of  
Environmental Protection**Notice is hereby given:**

Pursuant to West Virginia Code § 22-6A-10(b), notice is hereby given that the undersigned well operator has applied for a permit for well work or for a certificate of approval for the construction of an impoundment or pit.

**This Notice Shall Include:**

Pursuant to W. Va. Code § 22-6A-10(b), this notice shall include: (1) copies of the application; (2) the erosion and sediment control plan required by section seven of this article; and (3) the well plat.

Pursuant to W. Va. Code § 22-6A-10(f), this notice shall include: (1) a statement of the time limits for filing written comments; (2) who may file written comments; (3) the name and address of the secretary for the purpose of filing the comments and obtaining additional information; and (4) a statement that the persons may request, at the time of submitting written comments, notice of the permit decision and a list of persons qualified to test water.

Pursuant to W. Va. Code R. § 35-8-5.7.a, the operator shall provide the Well Site Safety Plan to the surface owner and any water purveyor or surface owner subject to notice and water testing as provided in section 15 of this rule.

Pursuant to W. Va. Code R. § 35-8-15.2.c, this notice shall: (1) contain a statement of the surface owner's and water purveyor's right to request sampling and analysis; (2) advise the surface owner and water purveyor of the rebuttable presumption for contamination or deprivation of a fresh water source or supply; advise the surface owner and water purveyor that refusal to allow the operator to conduct a pre-drilling water well test constitutes a method to rebut the presumption of liability; (3) advise the surface owner and water purveyor of his or her independent right to sample and analyze any water supply at his or her own expense; advise the surface owner and water purveyor whether or not the operator will utilize an independent laboratory to analyze any sample; and (4) advise the surface owner and or water purveyor that he or she can obtain from the Chief a list of water testing laboratories in the subject area capable of and qualified to test water supplies in accordance with standard acceptable methods.

Additional information related to horizontal drilling may be obtained from the Secretary, at the WV Department of Environmental Protection headquarters, located at 601 57<sup>th</sup> Street, SE, Charleston, WV 25304 (304-926-0450) or by visiting [www.dep.wv.gov/oil-and-gas/pages/default.aspx](http://www.dep.wv.gov/oil-and-gas/pages/default.aspx).

**Well Location Restrictions**

Pursuant to W. Va. Code § 22-6A-12, Wells may not be drilled within two hundred fifty feet measured horizontally from any existing water well or developed spring used for human or domestic animal consumption. The center of well pads may not be located within six hundred twenty-five feet of an occupied dwelling structure, or a building two thousand five hundred square feet or larger used to house or shelter dairy cattle or poultry husbandry. This limitation is applicable to those wells, developed springs, dwellings or agricultural buildings that existed on the date a notice to the surface owner of planned entry for surveying or staking as provided in section ten of this article or a notice of intent to drill a horizontal well as provided in subsection (b), section sixteen of this article was provided, whichever occurs first, and to any dwelling under construction prior to that date. This limitation may be waived by written consent of the surface owner transmitted to the department and recorded in the real property records maintained by the clerk of the county commission for the county in which such property is located. Furthermore, the well operator may be granted a variance by the secretary from these distance restrictions upon submission of a plan which identifies the sufficient measures, facilities or practices to be employed during well site construction, drilling and operations. The variance, if granted, shall include terms and conditions the department requires to ensure the safety and protection of affected persons and property. The terms and conditions may include insurance, bonding and indemnification, as well as technical requirements. (b) No well pad may be prepared or well drilled within one hundred feet measured horizontally from any perennial stream, natural or artificial lake, pond or reservoir, or a wetland, or within three hundred feet of a naturally reproducing trout stream. No well pad may be located within one thousand feet of a surface or ground water intake of a public water supply. The distance from the public water supply as identified by the department shall be measured as follows: (1) For a surface water intake on a lake or reservoir, the distance shall be measured from the boundary of the lake or reservoir. (2) For a surface water intake on a flowing stream, the distance shall be measured from a semicircular radius extending upstream of the surface water intake. (3) For a groundwater source, the distance shall be measured from the wellhead or spring. The department may, in its discretion, waive these distance restrictions upon submission of a plan identifying sufficient measures, facilities or practices to be employed during well site construction, drilling and operations to protect the waters of the state. A waiver, if granted, shall impose any permit conditions as the secretary considers necessary. (c) Notwithstanding the foregoing provisions of this section, nothing contained in this section prevents an operator from conducting the activities permitted or authorized by a Clean Water Act Section 404 permit or other approval from the United States Army Corps of Engineers within any waters of the state or within the restricted areas referenced in this section. (d) The well location restrictions set forth in this section shall not apply to any well on a multiple well pad if at least one of the wells was permitted prior to the effective date of this article. (e) The secretary shall, by December 31, 2012, report to the Legislature on the noise, light, dust and volatile organic compounds generated by the drilling of horizontal wells as they relate to the well location restrictions regarding occupied dwelling structures pursuant to this section. Upon a finding, if any, by the secretary that the well location restrictions regarding occupied dwelling structures are inadequate or otherwise require alteration to address the items



examined in the study required by this subsection, the secretary shall have the authority to propose for promulgation legislative rules establishing guidelines and procedures regarding reasonable levels of noise, light, dust and volatile organic compounds relating to drilling horizontal wells, including reasonable means of mitigating such factors, if necessary.

**Water Well Testing:**

Pursuant to West Virginia Code § 22-6A-10(d), notification shall be made, with respect to surface landowners identified in subsection (b) or water purveyors identified in subdivision (5), subsection (b) of this section, of the opportunity for testing their water well. The operator shall provide an analysis to such surface landowner or water purveyor at their request.

**Water Testing Laboratories:**

Pursuant to West Virginia Code § 22-6A-10(i), persons entitled to notice pursuant to subsection (b) of this section may contact the department to ascertain the names and locations of water testing laboratories in the subject area capable and qualified to test water supplies in accordance with standard accepted methods. In compiling that list of names the department shall consult with the state Bureau for Public Health and local health departments. A surface owner and water purveyor has an independent right to sample and analyze any water supply at his or her own expense. The laboratory utilized by the operator shall be approved by the agency as being certified and capable of performing sample analyses in accordance with this section.

**Rebuttable Presumption for Contamination or Deprivation of a Fresh Water Source or Supply:**

W. Va. Code § 22-6A-18 requires that (b) unless rebutted by one of the defenses established in subsection (c) of this section, in any action for contamination or deprivation of a fresh water source or supply within one thousand five hundred feet of the center of the well pad for horizontal well, there is a rebuttable presumption that the drilling and the oil or gas well or either was the proximate cause of the contamination or deprivation of the fresh water source or supply. (c) In order to rebut the presumption of liability established in subsection (b) of this section, the operator must prove by a preponderance of the evidence one of the following defenses: (1) The pollution existed prior to the drilling or alteration activity as determined by a predrilling or prealteration water well test. (2) The landowner or water purveyor refused to allow the operator access to the property to conduct a predrilling or prealteration water well test. (3) The water supply is not within one thousand five hundred feet of the well. (4) The pollution occurred more than six months after completion of drilling or alteration activities. (5) The pollution occurred as the result of some cause other than the drilling or alteration activity. (d) Any operator electing to preserve its defenses under subdivision (1), subsection (c) of this section shall retain the services of an independent certified laboratory to conduct the predrilling or prealteration water well test. A copy of the results of the test shall be submitted to the department and the surface owner or water purveyor in a manner prescribed by the secretary. (e) Any operator shall replace the water supply of an owner of interest in real property who obtains all or part of that owner's supply of water for domestic, agricultural, industrial or other legitimate use from an underground or surface source with a comparable water supply where the secretary determines that the water supply has been affected by contamination, diminution or interruption proximately caused by the oil or gas operation, unless waived in writing by that owner. (f) The secretary may order the operator conducting the oil or gas operation to: (1) Provide an emergency drinking water supply within twenty-four hours; (2) Provide temporary water supply within seventy-two hours; (3) Within thirty days begin activities to establish a permanent water supply or submit a proposal to the secretary outlining the measures and timetables to be used in establishing a permanent supply. The total time in providing a permanent water supply may not exceed two years. If the operator demonstrates that providing a permanent replacement water supply cannot be completed within two years, the secretary may extend the time frame on case-by-case basis; and (4) Pay all reasonable costs incurred by the real property owner in securing a water supply. (g) A person as described in subsection (b) of this section aggrieved under the provisions of subsections (b), (e) or (f) of this section may seek relief in court... (i) Notwithstanding the denial of the operator of responsibility for the damage to the real property owner's water supply or the status of any appeal on determination of liability for the damage to the real property owner's water supply, the operator may not discontinue providing the required water service until authorized to do so by the secretary or a court of competent jurisdiction.

**Written Comment:**

Pursuant to West Virginia Code § 22-6A-11(a), all persons described in subsection (b), section ten of this article may file written comments with the secretary as to the location or construction of the applicant's proposed well work within thirty days after the application is filed with the secretary. All persons described in West Virginia Code § 22-6A-10(b) may file written comments as to the location or construction of the applicant's proposed well work to the Secretary at:

Chief, Office of Oil and Gas  
Department of Environmental Protection  
601 57<sup>th</sup> St. SE  
Charleston, WV 25304  
(304) 926-0450

RECEIVED  
Office of Oil and Gas  
NOV 22 2017  
WV Department of  
Environmental Protection

Such persons may request, at the time of submitting written comments, notice of the permit decision and a list of persons qualified to test water. **NOTE: YOU ARE NOT REQUIRED TO FILE ANY COMMENT.**

**Time Limits and Methods for Filing Comments.**

The law requires these materials to be served on or before the date the operator files its Application. You have **THIRTY (30) DAYS** after the filing date to file your comments. Comments must be filed in person or received in the mail by the Chief's office by the time stated above. You may call the Chief's office to be sure of the date. Check with your postmaster to ensure adequate delivery time or to arrange special expedited handling. If you have been contacted by the well operator and you have signed a "voluntary statement of no objection" to the planned work described in these materials, then the permit may be issued at any time.

Pursuant to West Virginia Code § 22-6A-11(c)(2), Any objections of the affected coal operators and coal seam owners and lessees shall be addressed through the processes and procedures that exist under sections fifteen, seventeen and forty, article six of this chapter, as applicable and as incorporated into this article by section five of this article. The written comments filed by the parties entitled to notice under subdivisions (1), (2), (4), (5) and (6), subsection (b), section ten of this article shall be considered by the secretary in the permit issuance process, but the parties are not entitled to participate in the processes and proceedings that exist under sections fifteen, seventeen or forty, article six of this chapter, as applicable and as incorporated into this article by section five of this article.

**Comment Requirements**

Your comments must be in writing and include your name, address and telephone number, the well operator's name and well number and the approximate location of the proposed well site including district and county from the application. You may add other documents, such as sketches, maps or photographs to support your comments.

Disclaimer: All comments received will be placed on our web site <http://www.dep.wv.gov/oil-and-gas/Horizontal-Permits/Pages/default.aspx> and the applicant will automatically be forwarded an email notice that such comments have been submitted. The applicant will be expected to provide a response to comments submitted by any surface owner, water purveyor or natural gas storage operator noticed within the application.

**Permit Denial or Condition**

The Chief has the power to deny or condition a well work permit. Pursuant to West Virginia Code § 22-6A-8(d), the permit may not be issued or be conditioned, including conditions with respect to the location of the well and access roads prior to issuance if the director determines that:

- (1) The proposed well work will constitute a hazard to the safety of persons;
- (2) The plan for soil erosion and sediment control is not adequate or effective;
- (3) Damage would occur to publicly owned lands or resources; or
- (4) The proposed well work fails to protect fresh water sources or supplies.

A permit may also be denied under West Virginia Code § 22-6A-7(k), the secretary shall deny the issuance of a permit if the secretary determines that the applicant has committed a substantial violation of a previously issued permit for a horizontal well, including the applicable erosion and sediment control plan associated with the previously issued permit, or a substantial violation of one or more of the rules promulgated under this article, and in each instance has failed to abate or seek review of the violation within the time prescribed by the secretary pursuant to the provisions of subdivisions (1) and (2), subsection (a), section five of this article and the rules promulgated hereunder, which time may not be unreasonable.

Pursuant to West Virginia Code § 22-6A-10(g), any person entitled to submit written comments to the secretary pursuant to subsection (a), section eleven of this article, shall also be entitled to receive from the secretary a copy of the permit as issued or a copy of the order modifying or denying the permit if the person requests receipt of them as a part of the written comments submitted concerning the permit application. Such persons may request, at the time of submitting written comments, notice of the permit decision and a list of persons qualified to test water.

RECEIVED  
Office of Oil and Gas  
NOV 22 2017  
WV Department of  
Environmental Protection

4706101794

WW-6A  
(8-13)

API NO. 47- \_\_\_\_\_  
OPERATOR WELL NO. Kassay 2H  
Well Pad Name: Kassay

**Notice is hereby given by:**

Well Operator: Northeast Natural Energy LLC  
Telephone: 304-212-0422  
Email: hmedley@nne-llc.com

Address: 707 Virginia Street E., Suite 1200  
Charleston, WV 25301  
Facsimile: 304-241-5972

**Oil and Gas Privacy Notice:**

The Office of Oil and Gas processes your personal information, such as name, address and telephone number, as part of our regulatory duties. Your personal information may be disclosed to other State agencies or third parties in the normal course of business or as needed to comply with statutory or regulatory requirements, including Freedom of Information Act requests. Our office will appropriately secure your personal information. If you have any questions about our use or your personal information, please contact DEP's Chief Privacy Officer at [deprivacyofficer@wv.gov](mailto:deprivacyofficer@wv.gov).

*Helli mmedy*



Subscribed and sworn before me this 21 day of November, 2017.

*Cliff Allen Pate* Notary Public

My Commission Expires June 18, 2018

RECEIVED  
Office of Oil and Gas  
NOV 22 2017  
WV Department of  
Environmental Protection

**Surface Owner(s):**

Precision Oil and Gas, Inc.  
P.O. Box 884  
Bridgeport, WV 26330

Patty Kassay  
1991 Daybrook Road  
Fairview, WV 26570

Mr. Samuel W. and Stacy L. Matteo,  
C/o Ileen Morton Matteo (life estate)  
404 Country Road  
Fairview, WV 26570

**Surface Owner(s) – Road and/or Other Disturbance:**

Patty Kassay  
1991 Daybrook Road  
Fairview, WV 26570

Mr. Samuel W. and Stacy L. Matteo  
C/o Ileen Morton Matteo (life estate)  
404 Country Road  
Fairview, WV 26570

**Coal Owner or Lessee:**

CONSOL Mining Company LLC  
Attn: Analyst  
CNX Center  
1000 Consol Energy Drive  
Canonsburg, PA 15317-6506

Murray American Energy  
46226 National Road  
St. Clairsville, OH 43950

RECEIVED  
Office of Oil and Gas  
NOV 22 2017  
WV Department of  
Environmental Protection

**Surface Owner of Water Well and/or Water Purveyor:**


Patty Kassay  
1991 Daybrook Road  
Fairview, WV 26570

Bernice Tennant  
299 Ellis Tennant Hollow  
Fairview, WV 26570

Nancy Carpenter, et al  
1343 Bunner Ridge Road  
Fairmont, WV 26554

Angela Martin Mayle  
477 Country Road  
Fairview, WV 26570


RECEIVED  
Office of Oil and Gas  
NOV 22 2017  
WV Department of  
Environmental Protection

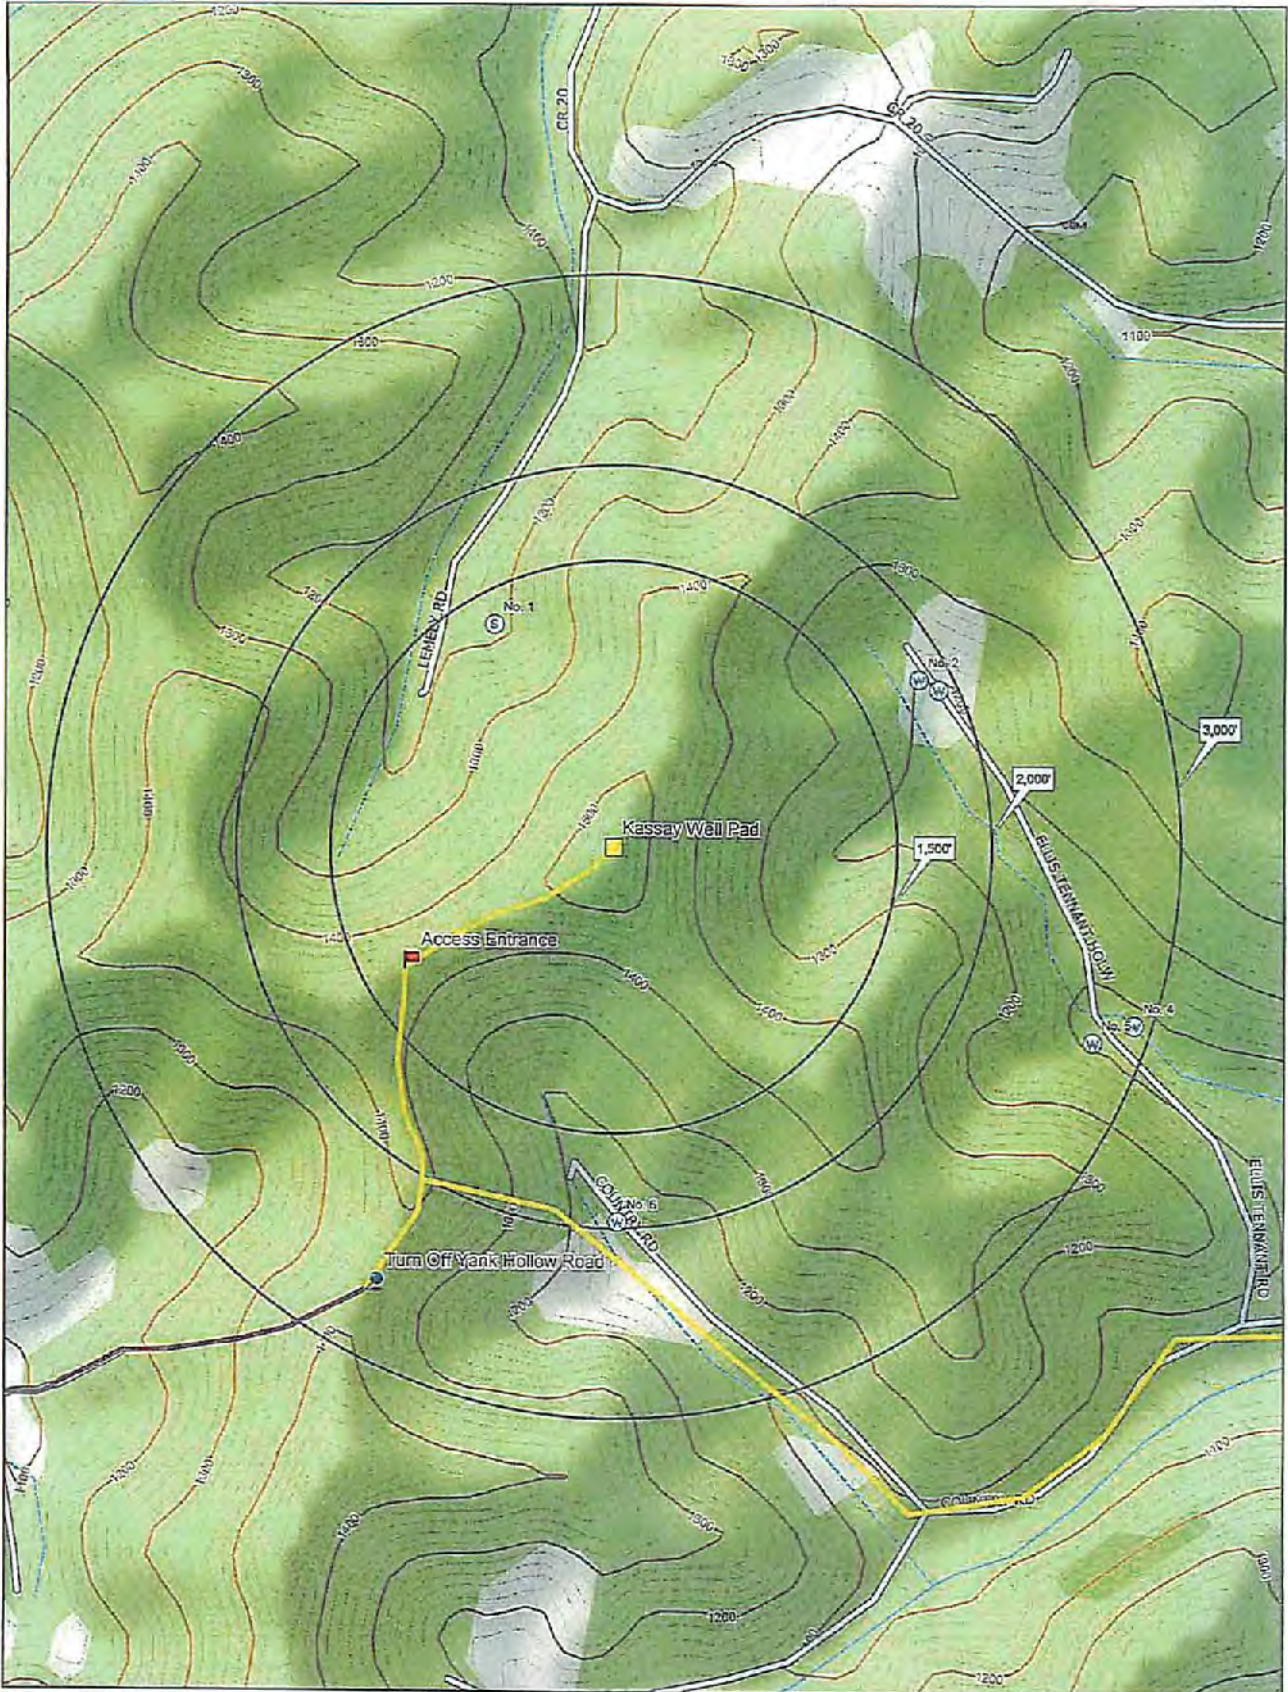

Data use subject to license.

© DeLorme, XMap® 7.

www.delorme.com

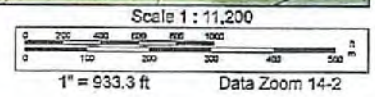

4706101794

### Kassay Water Well Location

	Surface Owner/Water Purveyor	Supply Type	Tax Map and Parcel	Latitude/Longitude
1	Patty Kassay	Spring Fed Pond	Tax Map 17, Parcel 48	39.661540, -80.196811
2	Bernice Tennant	Well	Tax Map 17, Parcel 64	39.660746, -80.188790
3	Bernice Tennant	Well	Tax Map 17, Parcel 64	39.660598, -80.188415
4	Nancy Carpenter, et al	Well	Tax Map 17, Parcel 73	39.655795, -80.184712
5	Nancy Carpenter, et al	Well	Tax Map 17, Parcel 73	39.655544, -80.185504
6	Angela M. Mayle	Well	Tax Map 17, Parcel 59.1	39.652950, -80.194444

REC'D  
Office of Oil and Gas

**MAR 16 2018**

WV Department of  
Environmental Protection

WW-6A3  
(1/12)

Operator Well No. Kassay

**STATE OF WEST VIRGINIA  
DEPARTMENT OF ENVIRONMENTAL PROTECTION, OFFICE OF OIL AND GAS  
NOTICE OF ENTRY FOR PLAT SURVEY**

**Notice Time Requirement:** Notice shall be provided at least SEVEN (7) days but no more than FORTY-FIVE (45) days prior to entry

**Date of Notice:** 12/18/2013      **Date of Planned Entry:** 12/26/2013

**Delivery method pursuant to West Virginia Code § 22-6A-10a**

- PERSONAL SERVICE
- REGISTERED MAIL
- METHOD OF DELIVERY THAT REQUIRES A RECEIPT OR SIGNATURE CONFIRMATION

Pursuant to West Virginia Code § 22-6A-10(a), Prior to filing a permit application, the operator shall provide notice of planned entry on the surface tract to conduct any plat surveys required pursuant to this article. Such notice shall be provided at least seven days but no more than forty-five days prior to such entry to: (1) The surface owner of such tract; (2) to any owner or lessee of coal seams beneath such tract that has filed a declaration pursuant to section thirty-six, article six, chapter twenty-two of this code; and (3) any owner of minerals underlying such tract in the county tax records. The notice shall include a statement that copies of the state Erosion and Sediment Control Manual and the statutes and rules related to oil and gas exploration and production may be obtained from the Secretary, which statement shall include contact information, including the address for a web page on the Secretary's web site, to enable the surface owner to obtain copies from the secretary.

**Notice is hereby provided to:**

SURFACE OWNER(s)

Name: See Attachment

Address: \_\_\_\_\_

Name: \_\_\_\_\_

Address: \_\_\_\_\_

Name: \_\_\_\_\_

Address: \_\_\_\_\_

COAL OWNER OR LESSEE

Name: See Attachment

Address: \_\_\_\_\_

MINERAL OWNER(s)

Name: See Attachment

Address: \_\_\_\_\_

\*please attach additional forms if necessary

**Notice is hereby given:**

Pursuant to West Virginia Code § 22-6A-10(a), notice is hereby given that the undersigned well operator is planning entry to conduct a plat survey on the tract of land as follows:

State: <u>West Virginia</u>	Approx. Latitude & Longitude: <u>569112.37, 4390193.76 (UTM NAD)</u>
County: <u>Monongalia</u>	Public Road Access: <u>State Rt. 20 (Memorial Road)</u>
District: <u>Clay</u>	Watershed: <u>Dunkard</u>
Quadrangle: <u>Blacksville, WV</u>	Generally used farm name: <u>Kassay</u>

Copies of the state Erosion and Sediment Control Manual and the statutes and rules related to oil and gas exploration and production may be obtained from the Secretary, at the WV Department of Environmental Protection headquarters, located at 601 57<sup>th</sup> Street, SE, Charleston, WV 25304 (304-926-0450). Copies of such documents or additional information related to horizontal drilling may be obtained from the Secretary by visiting [www.dep.wv.gov/oil-and-gas/pages/default.aspx](http://www.dep.wv.gov/oil-and-gas/pages/default.aspx).

**Notice is hereby given by:**

Well Operator: Northeast Natural Energy LLC

Telephone: 304.241.5752

Email: hmedley@nne-llc.com

Address: 707 Virginia Street East, Suite 1200  
Charleston, WV 25301

Facsimile: 304.241.5972

RECEIVED  
Office of Oil and Gas

NOV 22 2017

WV Department of  
Environmental Protection

**Oil and Gas Privacy Notice:**

The Office of Oil and Gas processes your personal information, such as name, address and telephone number, as part of our regulatory duties. Your personal information may be disclosed to other State agencies or third parties in the normal course of business or as needed to comply with statutory or regulatory requirements, including Freedom of Information Act requests. Our office will appropriately secure your personal information. If you have any questions about our use or your personal information, please contact DEP's Chief Privacy Officer at [depprivacyofficer@wv.gov](mailto:depprivacyofficer@wv.gov).



Surface Owner	Address
Nehemiah Kassay Patty Kassay	1991 Daybrook Road, Fairview, WV 26570
Precision Oil and Gas Inc.	P.O. Box 884, Bridgeport, WV 26330

Surface Owner - Access Road	Address
Nehemiah Kassay Patty Kassay	1991 Daybrook Road, Fairview, WV 26570

Mineral Owner	Address
Alice Wise, A Widow	8615 Tiber Hollow Court Louisville, KY 40219
Alma M. Joseph, A Widower	510 Brewer Street Akron, OH 44305
Almeada J. Barber, A Widow	22 Kurtz Street Apt 206 Athens, OH 45701
Ardella J. Clevenger	3 Karen Court Fairmont, WV 26554
Betty C. Lyons	316 North Main Street Bishop, CA 93514
Betty Lee Sine, Widow	Rt 1 Box 450 Riversville WV 26588
Billy Ray Tennant	658 Mooresville Road Core, WV 26541
C.W. Sine, A Single Man	4014 Trent Avenue Cleveland, OH 44109
Carol I Wise, Married	159 Pine Drive Poca, WV 26559
Celeste M Frickleton	11724 Dry River Ct. Reston, VA 20191
Cheryl Lisabeth Gallagher	2094 Croosroads Road Fairview, WV 26570
Connie Varner, A Single Woman	16005 Fleming Road Amesville, OH 45711
Darlene Eddy, A/K/A Darlene S.	910 Harlem Fairmont, WV 26554
Deborah Sudduth And Samuel	8480 Rural Dale Road Blue Rock, OH 43760
Dennis Keith Williams	Rt 1 Box 174 Fairmont, WV 26554
Diana Beth Thomas, A/K/A Diane	404 Brown Run Rd. Burton, WV 26590
Diane Beth Thomas And Curtis	404 Brown Run Rd. Burton, WV 26590
Donald R Sine, Married	5097 W. 148th Street Brook Park, OH 44142
Donald R. Sine And Irma Sine,	5097 W. 148th Street Brook Park, OH 44142
Donald Rex Williams	153 South Heritage Drive Jenkins, KY 41537
Donna Lynn Chase, Married	2833 West Roy E. Furman Highway Rogersville, PA 15359
Doris L Sine, Widow	4430 Fairmont Road Morgantown , WV 26501
Ellen J Woodruff, Widow	7529 Praire Road, NE, Albuquerque, NM 87109-1801
Emza M. Parsons, A Widow	607 Bryan Avenue Barrackville, WV 26559
Everett A Sine, Jr, Married	101 Mount Harmon Road Fairview, WV 26570
Freddy W Williams, Married	222 Happy Lane Fairview, WV 26570
Gail Church, Married	127 Dewey Ave. Spraggs, PA 15362
Ginger K. Estle	46 Breezy Drive Morgantown, WV 26501
Helen Cummings, A Widow	P.O. Box 277 Grant Town, WV 26574
James Everett Williams li	21200 State Rt. 676 Marietta, OH 45750
James Varner, A Single Man	16170 Fleming Road Amesville, OH 45711
Janet Varner, A Widow	16005 Fleming Road Amesville, OH 45711
Jarrold Williams	P.O. Box 311 Pentress, WV 26544
Jimmy Randall Tennant	15 Clint Moore Road Fairview, WV 26570
Jody L. Varner, A Single Man	P.O. Box 102 181 Water Street Duncan Falls, OH 43734
Joyce Ann Berga, A/K/A Joyce	619 Ruby Street Belmont, WV 26134
Karen J. Taylor, F/K/A Karen	50711 State Rt 7 New Matamoras, OH 45767
Karen M. Cain, A/K/A Karen	645 Hillwood Drive Morgantown, WV 26508
Kimberly Sue Brummage	2596 Daybrook Road Fairview, WV 26570

RECEIVED  
Office of Oil and Gas

NOV 22 2017

WV Department of  
Environmental Protection

Kristie Virgie Vedis	631 Daybrook Road Fairview, WV 26579	✓
Larry K Sine, Married	1101 Buffalo Road Mannington, WV 26582	✓
Larry Tennant, A Married Man	1110 Plum Road Mannington, WV 26582	✓
Leonard D Moore, Married	10754 Mason Dixon HWY Burton, WV 26562	✓
Leonard L Tennant, Married	206 Putney Road Cumberland, V A 23040	✓
Lisa And William Mccammon	6549 South Blackburn Road Athens, OH 45701	? ✓
Loretta Fluharty	Rt 3 Box 155A Mannington, WV	✓
Louise Varner, A Widow	99 Bean Road Lot 4 The Plains, OH 45780	✓
Lyall A Sine, Aka Lyal A Sine	355 Statler Run Road Fairview, WV 26570	✓
Lydia L. Troutman	46 Breezy Drive Morgantown, WV 26501	✓
Mabel L McAfee, Married	5208 Secretariat Run Spring Hill, FL 34609	✓ Same
Mabel L. McAfee, A Widow	5208 Secretariat Run Spring Hill, FL 34609	✓
Mark Varner, A Single Man	480 High Street Nelsonville, OH 45764	✓
Mary J. Pemberton, A/K/A Mary	149 Honeysuckle Lane Huntington, WV 25701	✓
Mary Liming, A Married Woman	4341 Mason Dixon Highway Core, WV	✓
Mary R. Mccullough, A Widow	1646 Morris Stret Washington, PA 15301	✓
Michelle Dawn Johnson And Eric	3306 Mason Dixon HWY Core, WV 26541	✓
Myrtle L. Sine	8044 Smokey Drain Road Core, WV 26529	✓
Nehemiah Kassay and Patty A. Kassay	1991 Daybrook Road, Fairview, WV 26570	✓
Nehemiah Kassay And Patty A. Kassay	1991 Daybrook Road, Fairview, WV 26570	✓
Nola M Williams, Widow	61 Vermillion Drive Pentress, WV 26544	rs ✓
Pamela Brown And Carl Brown	1327 Irish Road Philo, OH 43771	✓
Pamela J. Yurisko	RR 3 Box 197B Shinnston, WV26431	✓
Pamela Rena Hall, Married	290 Oak Street Waynesburg, PA 15370	✓
Patricia Ann Hostutler, Single	1460 Jakes Run Road Fairview, WV 26570	✓
Patricia Van Tassell, Married	7024 Pam Drive Millington, TN 38053	✓
Paul Varner, A Single Man	472 Scott Street Nelsonville, OH 45764	✓
Peggy A Morris, Married	37534 Landis Ave. Zephyrhills, FL 33541	? ✓
Raymer Tennant	154 Behler Road Fairview, WV 26570	✓
Rebecca Gail Foley	1175 Range Road Wadestown, WV 26590	rs ✓
Rebecca Lynne Strahler	307 Marion Street Marietta, OH 45750	? ✓
Richard Tennant	Rt 2 Box 335 C Fayetteville, WV 25840	✓
Rickey Jane Buchanan, A	4603 Red Tail Hawk Lane Waxhaw, NC 28173	✓
Robert Ora Wheeler And Paula	5210 Cass Street Oak Lawn, IL 60453	✓
Robert Varner, A Single Man	16005 Fleming Road Amesville, OH 45711	✓
Rodney Wayne Tennant	1733 Jakes Run Road Fairview, WV 26570	✓
Roxana Cahill	609 South Pine Grove Road Virginia Beach, VA 23452	✓
Ruby E. Van Fossen	1390 West Jackson Hill Court Laecanto, FL 34461	✓
Sandra Faye Wilson And Wayne	7725 Mason Dixon Highway Wana, WV 26590	✓
Steven Varner Sr. And Tina	21 Robbins Road Nelsonville, OH 45764	✓
Sue Ann Strickland, Married	6412 Colleen Ave., NE Albuquerque, NM 87109	✓
Susan L. Michael, A/K/A Susan	4256 Crossroads Road Fairview, WV 26570	✓
Tamela R. Simeral And Jerry	2207 Armco Avenue Zanesville, OH 43701	✓
Tina L. Fluharty And Richard	41 Finch Lane Mannington, WV 26582	✓
Tommy J. Eddy, Sr., A/K/A	3027 Daybrook Road Fairview, WV 26570	✓
Troy L. Tennant And Anna L.	Rt. 1 Box 169 B Fairmont, WV 26554	✓
Twyla Hinds Snopps	Rt 2 Box 367 Lost Creek, WV 26385	✓

RECEIVED  
Office of Oil and Gas

NOV 22 2017

WV Department of  
Environmental Protection

Varner L Moore, Married	7368 Mason Dixon HWY Wana, WV 26590	RS
W Richard Williams, Married	10809 US Highway 27 South Sebring, FL 33876	✓
Walden J. Cook, Jr.	340 1171st Street Middleton, IL 62666	? ✓

Coal Owner	Address
Consolidated Coal Company	1000 Consol Energy Drive, Canonsburg, PA

RECEIVED  
Office of Oil and Gas

NOV 22 2017

WV Department of  
Environmental Protection

**STATE OF WEST VIRGINIA**  
**DEPARTMENT OF ENVIRONMENTAL PROTECTION, OFFICE OF OIL AND GAS**  
**NOTICE OF INTENT TO DRILL**

Pursuant to W. Va. Code § 22-6A-16(b), the Notice of Intent to Drill is only required if the notice requirements of W. Va. Code § 22-6A-10(a) have NOT been met or if the Notice of Intent to Drill requirement has NOT been waived in writing by the surface owner.

**Notice Time Requirement:** Notice shall be provided at least TEN (10) days prior to filing a permit application.

**Date of Notice:** 11/09/2017

**Date Permit Application Filed:** 11/20/2017

**Delivery method pursuant to West Virginia Code § 22-6A-16(b)**

HAND DELIVERY       CERTIFIED MAIL  
RETURN RECEIPT REQUESTED

Pursuant to W. Va. Code § 22-6A-16(b), at least ten days prior to filing a permit application, an operator shall, by certified mail return receipt requested or hand delivery, give the surface owner notice of its intent to enter upon the surface owner's land for the purpose of drilling a horizontal well: *Provided*, That notice given pursuant to subsection (a), section ten of this article satisfies the requirements of this subsection as of the date the notice was provided to the surface owner: *Provided, however*, That the notice requirements of this subsection may be waived in writing by the surface owner. The notice, if required, shall include the name, address, telephone number, and if available, facsimile number and electronic mail address of the operator and the operator's authorized representative.

**Notice is hereby provided to the SURFACE OWNER(s):**

Name: Please See Attachment

Name: Please See Attachment

Address: \_\_\_\_\_

Address: \_\_\_\_\_

**Notice is hereby given:**

Pursuant to West Virginia Code § 22-6A-16(b), notice is hereby given that the undersigned well operator has an intent to enter upon the surface owner's land for the purpose of drilling a horizontal well on the tract of land as follows:

State: <u>West Virginia</u>	UTM NAD 83	Easting: <u>569098.6</u>
County: <u>Monongalia</u>		Northing: <u>4390146.1</u>
District: <u>Clay</u>	Public Road Access: <u>County Route 25/3 (Yank Hollow Road)</u>	
Quadrangle: <u>Blacksville</u>	Generally used farm name: <u>Kassay</u>	
Watershed: <u>Dunkard Creek</u>		

**This Notice Shall Include:**

Pursuant to West Virginia Code § 22-6A-16(b), this notice shall include the name, address, telephone number, and if available, facsimile number and electronic mail address of the operator and the operator's authorized representative. Additional information related to horizontal drilling may be obtained from the Secretary, at the WV Department of Environmental Protection headquarters, located at 601 57<sup>th</sup> Street, SE, Charleston, WV 25304 (304-926-0450) or by visiting [www.dep.wv.gov/oil-and-gas/pages/default.aspx](http://www.dep.wv.gov/oil-and-gas/pages/default.aspx).

**Notice is hereby given by:**

Well Operator: Northeast Natural Energy LLC  
Address: 707 Virginia Street East, Suite 1200  
Charleston, WV 25301  
Telephone: 304-414-7060  
Email: hmedley@nne-llc.com  
Facsimile: 304-414-7061

Authorized Representative: Hollie Medley, Regulatory Manager  
Address: 48 Donley Street, Suite 601  
Morgantown, WV 26501  
Telephone: 304-212-0422  
Email: hmedley@nne-llc.com  
Facsimile: 304-211-5972

**Oil and Gas Privacy Notice:**

The Office of Oil and Gas processes your personal information, such as name, address and telephone number, as part of our regulatory duties. Your personal information may be disclosed to other State agencies or third parties in the normal course of business or as needed to comply with statutory or regulatory requirements, including Freedom of Information Act requests. Our office will appropriately secure your personal information. If you have any questions about our use or your personal information, please contact DEP's Chief Privacy Officer at [depprivacyofficer@wv.gov](mailto:depprivacyofficer@wv.gov).

NOV 22 2017

WV Department of  
Environmental Protection

4706101794

Kassay 2H

Surface Owner(s):

Precision Oil and Gas, Inc.  
P.O. Box 884  
Bridgeport, WV 26330

Patty Kassay  
1991 Daybrook Road  
Fairview, WV 26570

Mr. Samuel W. and Stacy L. Matteo,  
C/o Ileen Morton Matteo (life estate)  
404 Country Road  
Fairview, WV 26570

RECEIVED  
Office of Oil and Gas

NOV 22 2017

WV Department of  
Environmental Protection

WW-6A5  
(1/12)

Operator Well No. Kassay 2H

**STATE OF WEST VIRGINIA**  
**DEPARTMENT OF ENVIRONMENTAL PROTECTION, OFFICE OF OIL AND GAS**  
**NOTICE OF PLANNED OPERATION**

**Notice Time Requirement:** notice shall be provided no later than the **filing date of permit application.**

**Date of Notice:** 11/09/2017      **Date Permit Application Filed:** 11/20/2017

**Delivery method pursuant to West Virginia Code § 22-6A-16(c)**

CERTIFIED MAIL                                       HAND  
RETURN RECEIPT REQUESTED                                      DELIVERY

Pursuant to W. Va. Code § 22-6A-16(c), no later than the date for filing the permit application, an operator shall, by certified mail return receipt requested or hand delivery, give the surface owner whose land will be used for the drilling of a horizontal well notice of the planned operation. The notice required by this subsection shall include: (1) A copy of this code section; (2) The information required to be provided by subsection (b), section ten of this article to a surface owner whose land will be used in conjunction with the drilling of a horizontal well; and (3) A proposed surface use and compensation agreement containing an offer of compensation for damages to the surface affected by oil and gas operations to the extent the damages are compensable under article six-b of this chapter. (d) The notices required by this section shall be given to the surface owner at the address listed in the records of the sheriff at the time of notice.

**Notice is hereby provided to the SURFACE OWNER(s)**  
(at the address listed in the records of the sheriff at the time of notice):

Name: Please See Attached                                      Name: Please See Attached  
Address: \_\_\_\_\_    Address: \_\_\_\_\_

**Notice is hereby given:**

Pursuant to West Virginia Code § 22-6A-16(c), notice is hereby given that the undersigned well operator has developed a planned operation on the surface owner's land for the purpose of drilling a horizontal well on the tract of land as follows:

State:	<u>West Virginia</u>	UTM NAD 83	Easting:	<u>569098.6</u>
County:	<u>Monongalia</u>		Northing:	<u>4390146.1</u>
District:	<u>Clay</u>	Public Road Access:	<u>County Route 25/3 (Yank Hollow Road)</u>	
Quadrangle:	<u>Blacksville</u>	Generally used farm name:	<u>Kassay</u>	
Watershed:	<u>Dunkard Creek</u>			

**This Notice Shall Include:**

Pursuant to West Virginia Code § 22-6A-16(c), this notice shall include: (1) A copy of this code section; (2) The information required to be provided by W. Va. Code § 22-6A-10(b) to a surface owner whose land will be used in conjunction with the drilling of a horizontal well; and (3) A proposed surface use and compensation agreement containing an offer of compensation for damages to the surface affected by oil and gas operations to the extent the damages are compensable under article six-b of this chapter. Additional information related to horizontal drilling may be obtained from the Secretary, at the WV Department of Environmental Protection headquarters, located at 601 57<sup>th</sup> Street, SE, Charleston, WV 25304 (304-926-0450) or by visiting [www.dep.wv.gov/oil-and-gas/pages/default.aspx](http://www.dep.wv.gov/oil-and-gas/pages/default.aspx).

Well Operator:	<u>Northeast Natural Energy LLC</u>	Address:	<u>707 Virginia Street East, Suite 1200</u>
Telephone:	<u>304-414-7060</u>		<u>Charleston, WV 25301</u>
Email:	<u>hmedley@nne-llc.com</u>	Facsimile:	<u>304-414-7061</u>

**Oil and Gas Privacy Notice:**

The Office of Oil and Gas processes your personal information, such as name, address and telephone number, as part of our regulatory duties. Your personal information may be disclosed to other State agencies or third parties in the normal course of business or as needed to comply with statutory or regulatory requirements, including Freedom of Information Act requests. Our office will appropriately secure your personal information. If you have any questions about our use or your personal information, please contact DEP's Chief Privacy Officer at [depprivacyofficer@wv.gov](mailto:depprivacyofficer@wv.gov).

RECEIVED  
Office of Oil and Gas  
NOV 22 2017  
WV Department of  
Environmental Protection

**Surface Owner(s):**

Precision Oil and Gas, Inc.  
P.O. Box 884  
Bridgeport, WV 26330

Patty Kassay  
1991 Daybrook Road  
Fairview, WV 26570

Mr. Samuel W. and Stacy L. Matteo,  
C/o Ileen Morton Matteo (life estate)  
404 Country Road  
Fairview, WV 26570

RECEIVED  
Office of Oil and Gas

NOV 22 2017

WV Department of  
Environmental Protection

STATE OF WEST VIRGINIA  
DEPARTMENT OF ENVIRONMENTAL PROTECTION, OFFICE OF OIL AND GAS  
**VOLUNTARY STATEMENT OF NO OBJECTION**

**Instructions to Persons Named on Page WW-6A**

The well operator named on page WW-6A is applying for a permit from the State of West Virginia to conduct oil or gas well work. Well work permits are valid for twenty-four (24) months. Please contact the listed well operator and the Office of Oil and Gas if you do not own an interest in the listed surface tract.

**Comment and Waiver Provisions**

Pursuant to West Virginia Code § 22-6A-11(a), all persons described in subsection (b), section ten of this article may file written comments with the secretary as to the location or construction of the applicant's proposed well work within thirty days after the application is filed with the secretary.

Pursuant to West Virginia Code § 22-6A-8(b) No permit may be issued less than thirty days after the filing date of the application for any well work except plugging or replugging; and no permit for plugging or replugging may be issued less than five days after the filing date of the application except a permit for plugging or replugging a dry hole: *Provided*, That if the applicant certifies that all persons entitled to notice of the application under the provisions of subsection (b), section ten of this article have been served in person or by certified mail, return receipt requested, with a copy of the well work application, including the erosion and sediment control plan, if required, and the well plat, and further files written statements of no objection by all such persons, the secretary may issue the well work permit at any time.

**VOLUNTARY STATEMENT OF NO OBJECTION**

I, Paul Smith, hereby state that I have read the Instructions to Persons Named on Page WW-6A and the associated provisions listed above, and that I have received copies of a Notice of Application, an Application for a Well Work Permit on Form WW-6A and attachments consisting of pages one (1) through \_\_\_\_\_, including the erosion and sediment control plan, if required, and the well plat, all for proposed well work on the tract of land as follows:

State:	<u>West Virginia</u>	UTM NAD 83 Easting:	<u>(2H) 569088.6 ; (4H) 569104.1 ; (6H) 569103.5 ; (10H) 569115.0</u>
County:	<u>Monongalia</u>	UTM NAD 83 Northing:	<u>(2H) 4390146.1 ; (4H) 4390157.0 ; (6H) 4390167.9 ; (10H) 4390178.8</u>
District:	<u>Clay</u>	Public Road Access:	<u>County Route 25/3 (Yank Hollow Road)</u>
Quadrangle:	<u>Blacksville</u>	Generally used farm name:	<u>Kassay</u>
Watershed:	<u>Dunkard Creek</u>		

I further state that I have no objection to the planned work described in these materials, and I have no objection to a permit being issued on those materials.

- \*Please check the box that applies
- SURFACE OWNER
  - SURFACE OWNER (Road and/or Other Disturbance)
  - SURFACE OWNER (Impoundments/Pits)
  - COAL OWNER OR LESSEE
  - COAL OPERATOR
  - WATER PURVEYOR
  - OPERATOR OF ANY NATURAL GAS STORAGE FIELD

**FOR EXECUTION BY A NATURAL PERSON**

Signature: [Signature]  
 Print Name: Paul E. Smith  
 Date: 11/14/17

**FOR EXECUTION BY A CORPORATION, ETC.**

Company: Precision Oil and Gas, Inc.  
 By: \_\_\_\_\_  
 Its: \_\_\_\_\_

Signature: \_\_\_\_\_  
 Date: \_\_\_\_\_

RECEIVED  
Office of Oil and Gas  
NOV 22 2017  
WV Department of  
Environmental Protection

**Oil and Gas Privacy Notice:**

The Office of Oil and Gas processes your personal information, such as name, address and telephone number, as part of our regulatory duties. Your personal information may be disclosed to other State agencies or third parties in the normal course of business or as needed to comply with statutory or regulatory requirements, including Freedom of Information Act requests. Our office will appropriately secure your personal information. If you have any questions about our use or your personal information, please contact DEP's Chief Privacy Officer at [depprivacyofficer@wv.gov](mailto:depprivacyofficer@wv.gov).



STATE OF WEST VIRGINIA  
DEPARTMENT OF ENVIRONMENTAL PROTECTION, OFFICE OF OIL AND GAS  
**VOLUNTARY STATEMENT OF NO OBJECTION**

**Instructions to Persons Named on Page WW-6A**

The well operator named on page WW-6A is applying for a permit from the State of West Virginia to conduct oil or gas well work. Well work permits are valid for twenty-four (24) months. Please contact the listed well operator and the Office of Oil and Gas if you do not own any interest in the listed surface tract.

**Comment and Waiver Provisions**

Pursuant to West Virginia Code § 22-6A-11(a), all persons described in subsection (b), section ten of this article may file written comments with the secretary as to the location or construction of the applicant's proposed well work within thirty days after the application is filed with the secretary.

Pursuant to West Virginia Code § 22-6A-8(b) No permit may be issued less than thirty days after the filing date of the application for any well work except plugging or replugging; and no permit for plugging or replugging may be issued less than five days after the filing date of the application except a permit for plugging or replugging a dry hole: *Provided*, That if the applicant certifies that all persons entitled to notice of the application under the provisions of subsection (b), section ten of this article have been served in person or by certified mail, return receipt requested, with a copy of the well work application, including the erosion and sediment control plan, if required, and the well plat, and further files written statements of no objection by all such persons, the secretary may issue the well work permit at any time.

**VOLUNTARY STATEMENT OF NO OBJECTION**

I, Bernie Dorman, hereby state that I have read the Instructions to Persons Named on Page WW-6A and the associated provisions listed above, and that I have received copies of a Notice of Application, an Application for a Well Work Permit on Form WW-6A and attachments consisting of pages one (1) through \_\_\_\_\_, including the erosion and sediment control plan, if required, and the well plat, all for proposed well work on the tract of land as follows:

State: West Virginia UTM NAD 83 Easting: (2H) 569090.0 ; (4H) 569104.1 ; (6H) 569109.5 ; (10H) 569115.0  
County: Monongalia Northing: (2H) 4390146.1 ; (4H) 4390157.0 ; (6H) 4390167.9 ; (10H) 4390178.0  
District: Clay Public Road Access: County Route 25/3 (Yank Hollow Road)  
Quadrangle: Blacksville Generally used farm name: Kassay  
Watershed: Dunkard Creek

I further state that I have no objection to the planned work described in these materials, and I have no objection to a permit being issued on those materials.

\*Please check the box that applies

- SURFACE OWNER
- SURFACE OWNER (Road and/or Other Disturbance)
- SURFACE OWNER (Impoundments/Pits)
- COAL OWNER OR LESSEE
- COAL OPERATOR
- WATER PURVEYOR
- OPERATOR OF ANY NATURAL GAS STORAGE FIELD

**FOR EXECUTION BY A NATURAL PERSON**

Signature: Bernie Dorman  
Print Name: Bernie Dorman  
Date: 11-12-2017

**FOR EXECUTION BY A CORPORATION, ETC.**

Company: \_\_\_\_\_  
By: \_\_\_\_\_  
Its: \_\_\_\_\_

Signature: \_\_\_\_\_  
Date: \_\_\_\_\_

RECEIVED  
Office of Oil and Gas  
NOV 22 2017

**Oil and Gas Privacy Notice:**

The Office of Oil and Gas processes your personal information, such as name, address and telephone number, as part of our regulatory duties. Your personal information may be disclosed to other State agencies or third parties in the normal course of business or as needed to comply with statutory or regulatory requirements, including Freedom of Information Act requests. Our office will appropriately secure your personal information. If you have any questions about our use or your personal information, please contact DEP's Chief Privacy Officer at [depprivacyofficer@wv.gov](mailto:depprivacyofficer@wv.gov).

WV Department of  
Environmental Protection

**STATE OF WEST VIRGINIA**  
**DEPARTMENT OF ENVIRONMENTAL PROTECTION, OFFICE OF OIL AND GAS**  
**VOLUNTARY STATEMENT OF NO OBJECTION**

**Instructions to Persons Named on Page WW-6A**

The well operator named on page WW-6A is applying for a permit from the State of West Virginia to conduct oil or gas well work. Well work permits are valid for twenty-four (24) months. Please contact the listed well operator and the Office of Oil and Gas if you do not own any interest in the listed surface tract.

**Comment and Waiver Provisions**

Pursuant to West Virginia Code § 22-6A-11(a), all persons described in subsection (b), section ten of this article may file written comments with the secretary as to the location or construction of the applicant's proposed well work within thirty days after the application is filed with the secretary.

Pursuant to West Virginia Code § 22-6A-8(b) No permit may be issued less than thirty days after the filing date of the application for any well work except plugging or replugging; and no permit for plugging or replugging may be issued less than five days after the filing date of the application except a permit for plugging or replugging a dry hole: *Provided*, That if the applicant certifies that all persons entitled to notice of the application under the provisions of subsection (b), section ten of this article have been served in person or by certified mail, return receipt requested, with a copy of the well work application, including the erosion and sediment control plan, if required, and the well plat, and further files written statements of no objection by all such persons, the secretary may issue the well work permit at any time.

**VOLUNTARY STATEMENT OF NO OBJECTION**

I, Casey V. Saunders, hereby state that I have read the Instructions to Persons Named on Page WW-6A and the associated provisions listed above, and that I have received copies of a Notice of Application, an Application for a Well Work Permit on Form WW-6A and attachments consisting of pages one (1) through <sup>16</sup>, including the erosion and sediment control plan, if required, and the well plat, all for proposed well work on the tract of land as follows:

State:	<u>West Virginia</u>	UTM NAD 83 Easting:	<u>(2H) 569036.6 ; (4H) 569104.1 ; (6H) 569109.5 ; (10H) 569115.0</u>
County:	<u>Monongalia</u>	UTM NAD 83 Northing:	<u>(2H) 4390146.1 ; (4H) 4390157.0 ; (6H) 4390167.9 ; (10H) 4390173.5</u>
District:	<u>Clay</u>	Public Road Access:	<u>County Route 26/3 (Yank Hollow Road)</u>
Quadrangle:	<u>Blacksville</u>	Generally used farm name:	<u>Kassay</u>
Watershed:	<u>Dunkard Creek</u>		

I further state that I have no objection to the planned work described in these materials, and I have no objection to a permit being issued on those materials.

<p>*Please check the box that applies</p> <p><input type="checkbox"/> SURFACE OWNER</p> <p><input type="checkbox"/> SURFACE OWNER (Road and/or Other Disturbance)</p> <p><input type="checkbox"/> SURFACE OWNER (Impoundments/Pits)</p> <p><input checked="" type="checkbox"/> COAL OWNER OR LESSEE</p> <p><input type="checkbox"/> COAL OPERATOR</p> <p><input type="checkbox"/> WATER PURVEYOR</p> <p><input type="checkbox"/> OPERATOR OF ANY NATURAL GAS STORAGE FIELD</p>	<p style="text-align: center;"><b>FOR EXECUTION BY A NATURAL PERSON</b></p> <p>Signature: _____</p> <p>Print Name: _____</p> <p>Date: _____</p> <p style="text-align: center;"><b>FOR EXECUTION BY A CORPORATION, ETC.</b></p> <p>Company: <u>CONSOL Mining Company LLC</u></p> <p>By: <u>Casey V. Saunders</u></p> <p>Its: <u>Manager Coal/Gas Coordination</u></p> <p>Signature: <u><i>Casey V. Saunders</i></u></p> <p>Date: <u>03/08/2018</u></p>
--	---

**Oil and Gas Privacy Notice:**

The Office of Oil and Gas processes your personal information, such as name, address and telephone number, as part of our regulatory duties. Your personal information may be disclosed to other State agencies or third parties in the normal course of business or as needed to comply with statutory or regulatory requirements, including Freedom of Information Act requests. Our office will appropriately secure your personal information. If you have any questions about our use of your personal information, please contact DEP's Chief Privacy Officer at [depprivacyofficer@wv.gov](mailto:depprivacyofficer@wv.gov).

RECEIVED  
Office of Oil and Gas

MAR 16 2018

**STATE OF WEST VIRGINIA  
DEPARTMENT OF ENVIRONMENTAL PROTECTION, OFFICE OF OIL AND GAS  
VOLUNTARY STATEMENT OF NO OBJECTION**

**Instructions to Persons Named on Page WW-6A**

The well operator named on page WW-6A is applying for a permit from the State of West Virginia to conduct oil or gas well work. Well work permits are valid for twenty-four (24) months. Please contact the listed well operator and the Office of Oil and Gas if you do not own any interest in the listed surface tract.

**Comment and Waiver Provisions**

Pursuant to West Virginia Code § 22-6A-11(a), all persons described in subsection (b), section ten of this article may file written comments with the secretary as to the location or construction of the applicant's proposed well work within thirty days after the application is filed with the secretary.


Pursuant to West Virginia Code § 22-6A-8(b) No permit may be issued less than thirty days after the filing date of the application for any well work except plugging or replugging; and no permit for plugging or replugging may be issued less than five days after the filing date of the application except a permit for plugging or replugging a dry hole: *Provided*, That if the applicant certifies that all persons entitled to notice of the application under the provisions of subsection (b), section ten of this article have been served in person or by certified mail, return receipt requested, with a copy of the well work application, including the erosion and sediment control plan, if required, and the well plat, and further files written statements of no objection by all such persons, the secretary may issue the well work permit at any time.

**VOLUNTARY STATEMENT OF NO OBJECTION**

I, Alex O'Neill, hereby state that I have read the Instructions to Persons Named on Page WW-6A and the associated provisions listed above, and that I have received copies of a Notice of Application, an Application for a Well Work Permit on Form WW-6A and attachments consisting of pages one (1) through 15, including the erosion and sediment control plan, if required, and the well plat, all for proposed well work on the tract of land as follows:

State: <u>West Virginia</u>	UTM NAD 83 Easting: <u>(2H) 568098.6 ; (4H) 569104.1 ; (6H) 569109.5 ; (10H) 569115.0</u>
County: <u>Monongalia</u>	UTM NAD 83 Northing: <u>(2H) 4390146.1 ; (4H) 4390157.0 ; (6H) 4390167.9 ; (10H) 4390178.8</u>
District: <u>Clay</u>	Public Road Access: <u>County Route 25/3 (Yank Hollow Road)</u>
Quadrangle: <u>Blacksville</u>	Generally used farm name: <u>Kassay</u>
Watershed: <u>Dunkard Creek</u>	

I further state that I have no objection to the planned work described in these materials, and I have no objection to a permit being issued on those materials.
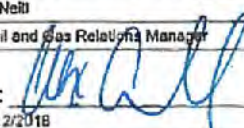
<p>*Please check the box that applies</p> <p><input type="checkbox"/> SURFACE OWNER</p> <p><input type="checkbox"/> SURFACE OWNER (Road and/or Other Disturbance)</p> <p><input type="checkbox"/> SURFACE OWNER (Impoundments/Pits)</p> <p><input checked="" type="checkbox"/> COAL OWNER OR LESSEE</p> <p><input type="checkbox"/> COAL OPERATOR</p> <p><input type="checkbox"/> WATER PURVEYOR</p> <p><input type="checkbox"/> OPERATOR OF ANY NATURAL GAS STORAGE FIELD</p>	<p><b>FOR EXECUTION BY A NATURAL PERSON</b></p> <p>Signature: _____</p> <p>Print Name: _____</p> <p>Date: _____</p> <p><b>FOR EXECUTION BY A CORPORATION, ETC.</b></p> <p>Company: <u>Murray American Energy, Inc.</u></p> <p>By: <u>Alex O'Neill</u></p> <p>Its: <u>Coal, Oil and Gas Relations Manager</u></p> <p>Signature: </p> <p>Date: <u>03/12/2018</u></p>
--	--

**Oil and Gas Privacy Notice:**

The Office of Oil and Gas processes your personal information, such as name, address and telephone number, as part of our regulatory duties. Your personal information may be disclosed to other State agencies or third parties in the normal course of business or as needed to comply with statutory or regulatory requirements, including Freedom of Information Act requests. Our office will appropriately secure your personal information. If you have any questions about our use or your personal information, please contact DEP's Chief Privacy Officer at [depprivacyofficer@wv.gov](mailto:depprivacyofficer@wv.gov).

RECEIVED  
Office of Oil and Gas

MAR 16 2018

WV Department of  
Environmental Protection



## WEST VIRGINIA DEPARTMENT OF TRANSPORTATION

**Division of Highways**

1900 Kanawha Boulevard East • Building Five • Room 110  
 Charleston, West Virginia 25305-0430 • (304) 558-3505

Jim Justice  
 Governor

Thomas J. Smith, P. E.  
 Secretary of Transportation/  
 Commissioner of Highways

James A. Martin, Chief  
 Office of Oil and Gas  
 Department of Environmental Protection  
 601 57<sup>th</sup> Street, SE  
 Charleston, WV 25304

Subject: DOH Permit for the Kassay Pad, Monongalia County  
 Kassay 2H

Dear Mr. Martin,

This well site will be accessed from a permit #04-2014-0914 issued to Northeast Natural Energy Corporation for access to the State Road for a well site located off of Monongalia Route 25/3 SLS.

The operator has signed a DISTRICT WIDE OIL AND GAS ROAD MAINTENANCE BONDING AGREEMENT and provided the required Bond. This operator is currently in compliance with the DOH OIL AND GAS POLICY dated January 3, 2012.

Very Truly Yours,

Gary K. Clayton, P.E.  
 Regional Maintenance Engineer  
 Central Office O&G Coordinator

Cc: Hollie Medley  
 Northeast Natural Energy Corporation  
 CH, OM, D-4  
 File

RECEIVED  
 Office of Oil and Gas

NOV 22 2017

WV Department of  
 Environmental Protection

4706101794

## Planned Additives to be used in Fracturing Stimulations

Trade Name	Purpose	Ingredients	Chemical Abstract Service Number (CAS#)
Water	Carrier	Water	7732-18-5
HCl, 10.1-15%	Acidizing	Hydrochloric Acid Water	7647-01-0 7732-18-5
Alpha 1427	Biocide	Alkyl Dimethyl Benzyl Ammonium Chloride (C12-16) Ethanol Glutaraldehyde Quaternary Ammonium Chloride Water	68424-85-1 64-17-5 111-30-8 7173-51-5 7732-18-5
Enzyme G-NE	Breaker	Hemicellulase Enzyme Concentrate Water	9025-56-3 7732-18-5
CI-14	Corrosion Inhibitor	Fatty Acids Methanol Olefin Polyoxyalkylenes Propargyl Alcohol	N.A. 67-56-1 N.A. N.A. 107-19-7
FRW-18	Friction Reducer	Hydrotreated Light Distillate	64742-47-8
GW-3LDF	Gelling Agent	Guar Gum Petroleum Distillate Blend	9000-30-0 CBI
Ferrotrol 300L	Iron Control	Citric Acid	77-92-9
Sand, White, 40/70	Proppant	Crystalline Silica (Quartz)	14808-60-7
Sand, White, 100 mesh	Proppant	Crystalline Silica (Quartz)	14808-60-7
Scaletrol 720	Scale Inhibitor	Diethylene Glycol	111-46-6

RECEIVED  
Office of Oil and Gas  
NOV 22 2017  
WV Department of  
Environmental Protection

**WEST VIRGINIA 811**

TWO WORKING DAYS PRIOR TO EXCAVATION, THE CONTRACTOR MUST CONTACT THE WV ONE CALL SYSTEM, INC., 1-800-245-4848

# KASSAY WELL PAD AS-BUILT

## CLAY DISTRICT, MONONGALIA COUNTY, WV

### JANUARY 2017 (REVISED DECEMBER 2017)

PLANS PREPARED BY:

**BOORD BENCHEK & ASSOCIATES, INC.**  
ENGINEERING, SURVEYING, CONSTRUCTION AND MINING SERVICES  
SOUTHPOINTE, PA 15317 PHONE: 724-746-1055

OWNER



**northeast**  
NATURAL ENERGY

707 VIRGINIA STREET  
SUITE 1200 CHARLESTON, WV 25301

**WVDEP O&G  
ACCEPTED AS-BUILT**

*WJL* 1/5/2018


SHEET INDEX  
1. TITLE SHEET  
2-3. EVACUATION ROUTE/ PREVAILING WINDS  
4. AS-BUILT OVERVIEW  
5-11. AS BUILT  
12-13. ACCESS ROAD PROFILES  
13a. MOUNTABLE BERM PROFILE AND CELLAR DETAIL  
14. RECLAMATION PLAN OVERVIEW  
15-21. RECLAMATION PLAN

TOTAL DISTURBED AREA: 15.85 ACRES  
ROAD DISTURBED AREA: 2.81 ACRES  
WELL PAD DISTURBED AREA: 13.04 ACRES  
ACCESS ROAD LENGTH: 2,843'  
ACCESS ROAD AVG. WIDTH: 24'  
WELL PAD ELEVATION: 1534'

API NUMBERS  
KASSAY 1H - 061-01731  
KASSAY 3H - 061-01704  
KASSAY 5H - 061-01694  
KASSAY 8H - 061-01740  
KASSAY 9H - 061-01695  
KASSAY 13H - 061-01689




*Andrew Benchek* 12-11-17  
\_\_\_\_\_  
ANDREW BENCHEK DATE  
P.E.

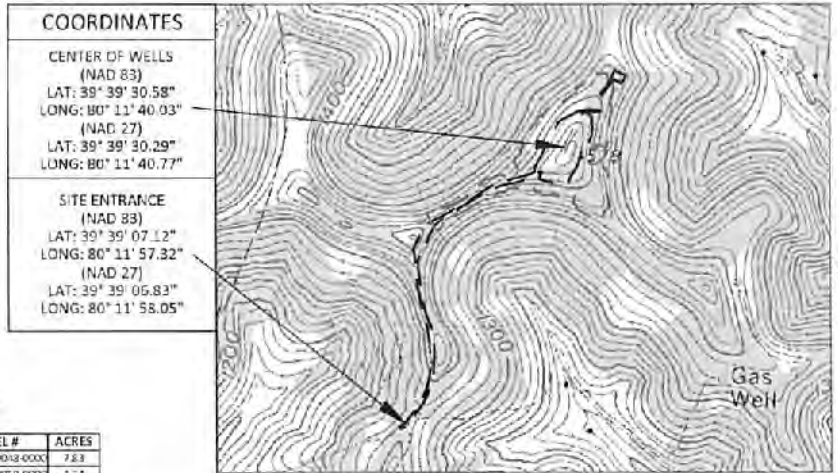

WV INSPECTOR: \_\_\_\_\_

PROPERTY OWNER PROJECT BOUNDARY ACREAGE		
PROPERTY OWNER	PARCEL #	ACRES
NEHEMIAH KASSAY	31-04-0017-0013-0000	7.83
SAMUEL W. & STACEY L. MATTED	31-04-0017-0059-0000	3.24
PRECISION OIL & GAS INC.	31-04-0017-0052-0000	4.78

<b>TITLE SHEET</b> KASSAY WELL PAD CLAY DISTRICT, MONONGALIA COUNTY, WV	<b>SHEET</b> 1 OF 21
---	-------------------------------

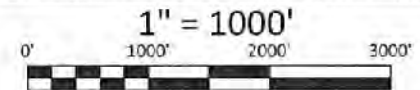




**WVDEP OOG  
ACCEPTED AS-BUILT**  
1/5/2018

- LEGEND**
- X X X X = SUPER SILT FENCE (SSF)
  - = PROJECT BOUNDARY (15.85 ACRES)
  - = PROPERTY LINE
  - = AS-BUILT 10' CONTOURS
  - = AS-BUILT 2' CONTOURS
  - = EXISTING 10' CONTOURS
  - = EXISTING 2' CONTOURS
  - = EXISTING ROAD
  - = EXISTING WATERLINE
  - = EXISTING GAS LINE
  - = STAKED WELL
  - = PROPOSED WELL

BOARD, BENCHEK and ASSOC., INC.  
Engineering, Surveying, Construction,  
and Mining Services  
Southpointe, PA 15317 Phone: 724-746-1055

**AS-BUILT**  
THIS DOCUMENT WAS PREPARED BY:  
BOARD, BENCHEK AND ASSOC., INC.  
FOR: NORTHEAST NATURAL ENERGY, LLC.

DATE:  
JANUARY 2017  
(REVISED DECEMBER  
2017)  
KASSAY  
WELL PAD  
CLAY DISTRICT,  
MONONGALIA  
COUNTY, WV

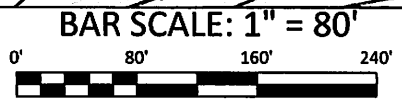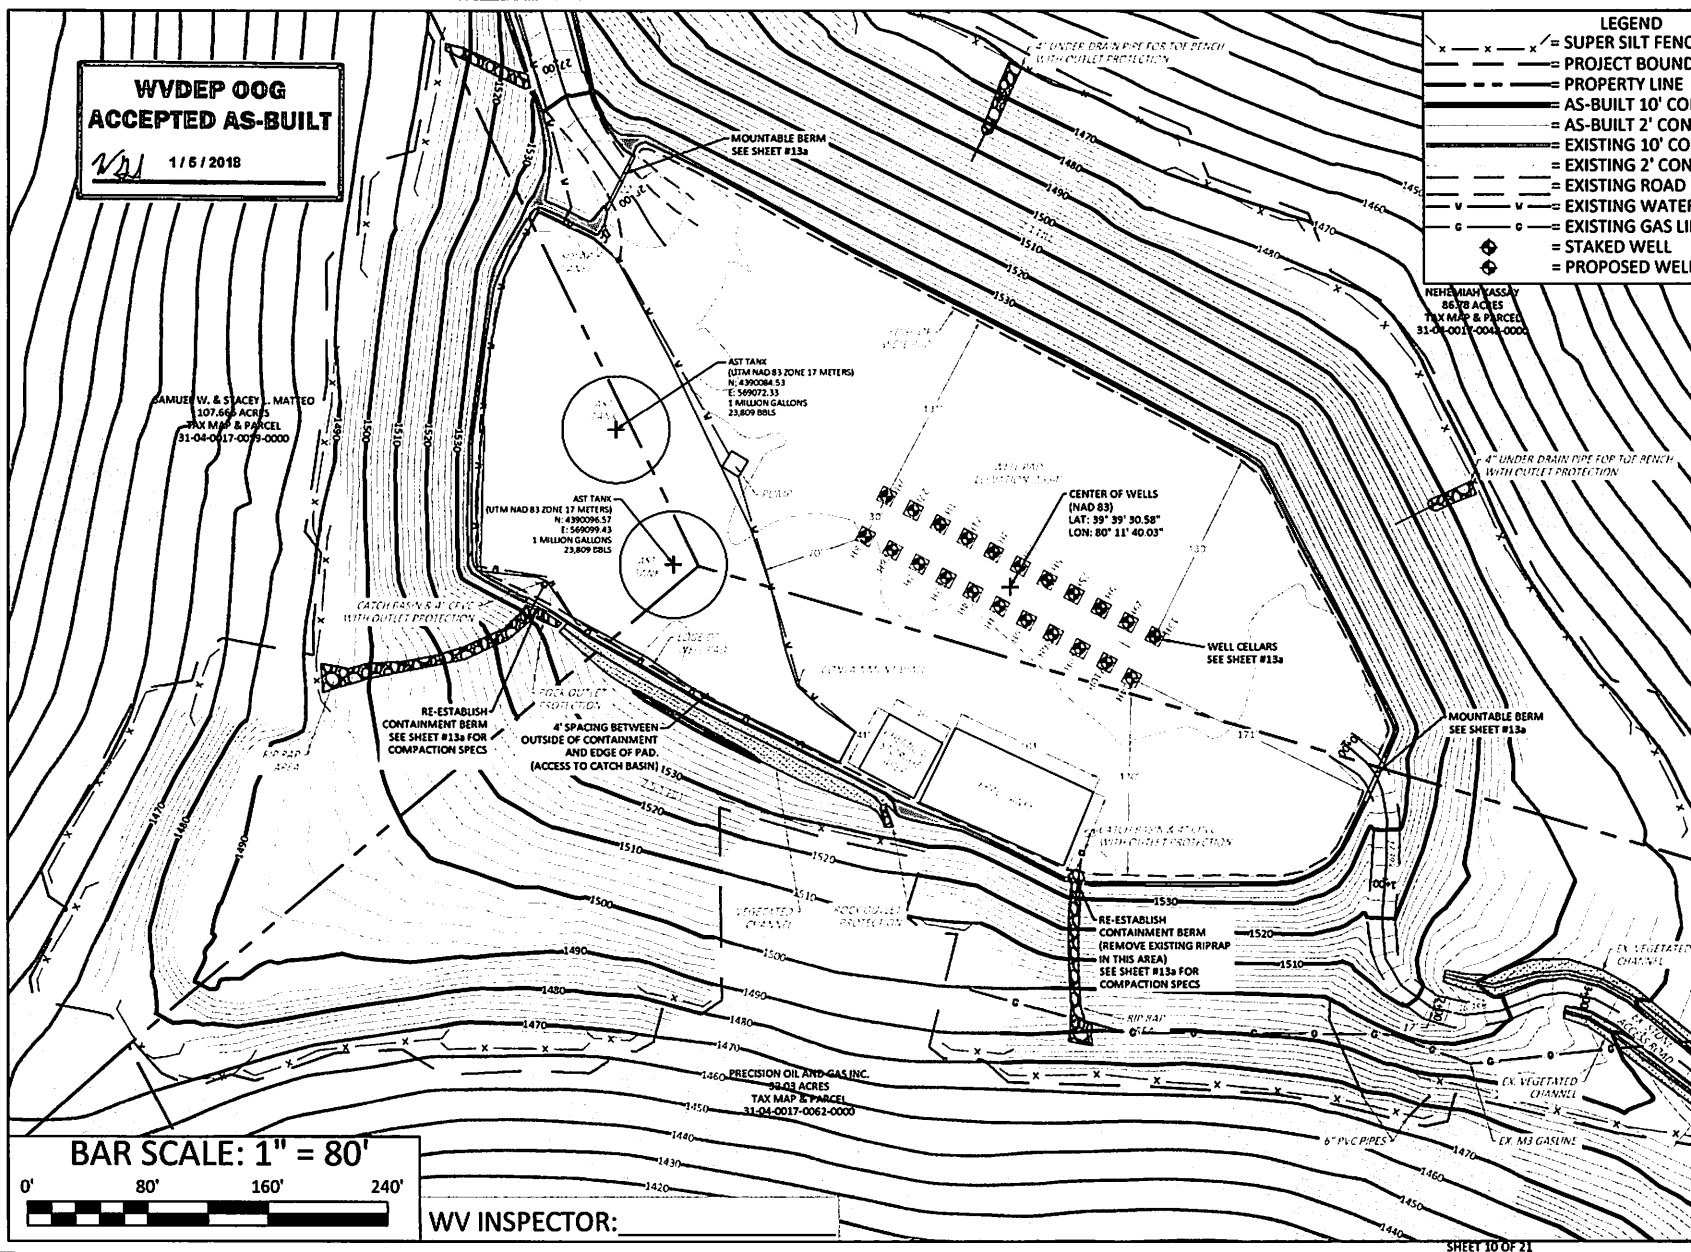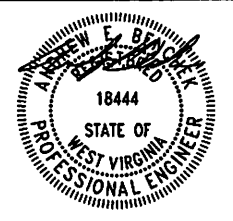

WV INSPECTOR: \_\_\_\_\_

APPROVED  
WVDEP OOG  
12/29/2014

# EROSION & SEDIMENT CONTROL PLAN

## KASSAY WELL PAD

MONONGALIA COUNTY, WEST VIRGINIA

FOR

# NORTHEAST NATURAL ENERGY LLC

API#6101689  
API#6101694  
API#6101695

Electronic Version of These Plans May Be Viewed at: Q:\OIL GAS\SAY FILES\REVIEWS



REFERENCE: USGS - BLACKSVILLE QUADRANGLE, WV 7.5 MINUTE SERIES



PROJECT NO. 1333001  
DECEMBER 2014

DIEFFENBAUCH & HRITZ, LLC



INDEX	
DRAWING NO.	TITLE
1	TITLE SHEET
2	GENERAL NOTES
3	EXISTING SITE PLAN
4	OVERALL SITE PLAN
5.8	PROPOSED SITE PLAN
8-12	ACCESS ROAD PROFILE
11	SOILS PLAN
13-15	SITE RESTORATION PLAN
16	REVEGETATION PLAN
17	TYPICAL SECTIONS
18-20	E&S DETAILS


OVERALL LIMITS OF DISTURBANCE: 15.68 AC  
PROPOSED DESIGN ELEMENTS  
ACCESS ROAD: 2.95 AC  
WELL PAD: 15.68 AC  
LAND OWNERS  
KASSAY: 7.53 AC  
MATTIO: 8.24 AC  
PRECISION OIL & GAS INC.: 4.78 AC

RECEIVED  
Office of Oil and Gas  
NOV 22 2017  
WV Department of  
Environmental Protection

PROJECT: KASSAY WELL SITE  
CLIENT: NORTHEAST NATURAL ENERGY LLC  
DESIGNER: DIEFFENBAUCH & HRITZ, LLC  
MORGANTOWN, WV  
SHEET: 1



**APPROVED**  
**WVDEP OOG**  
DATE: 12/29/2014

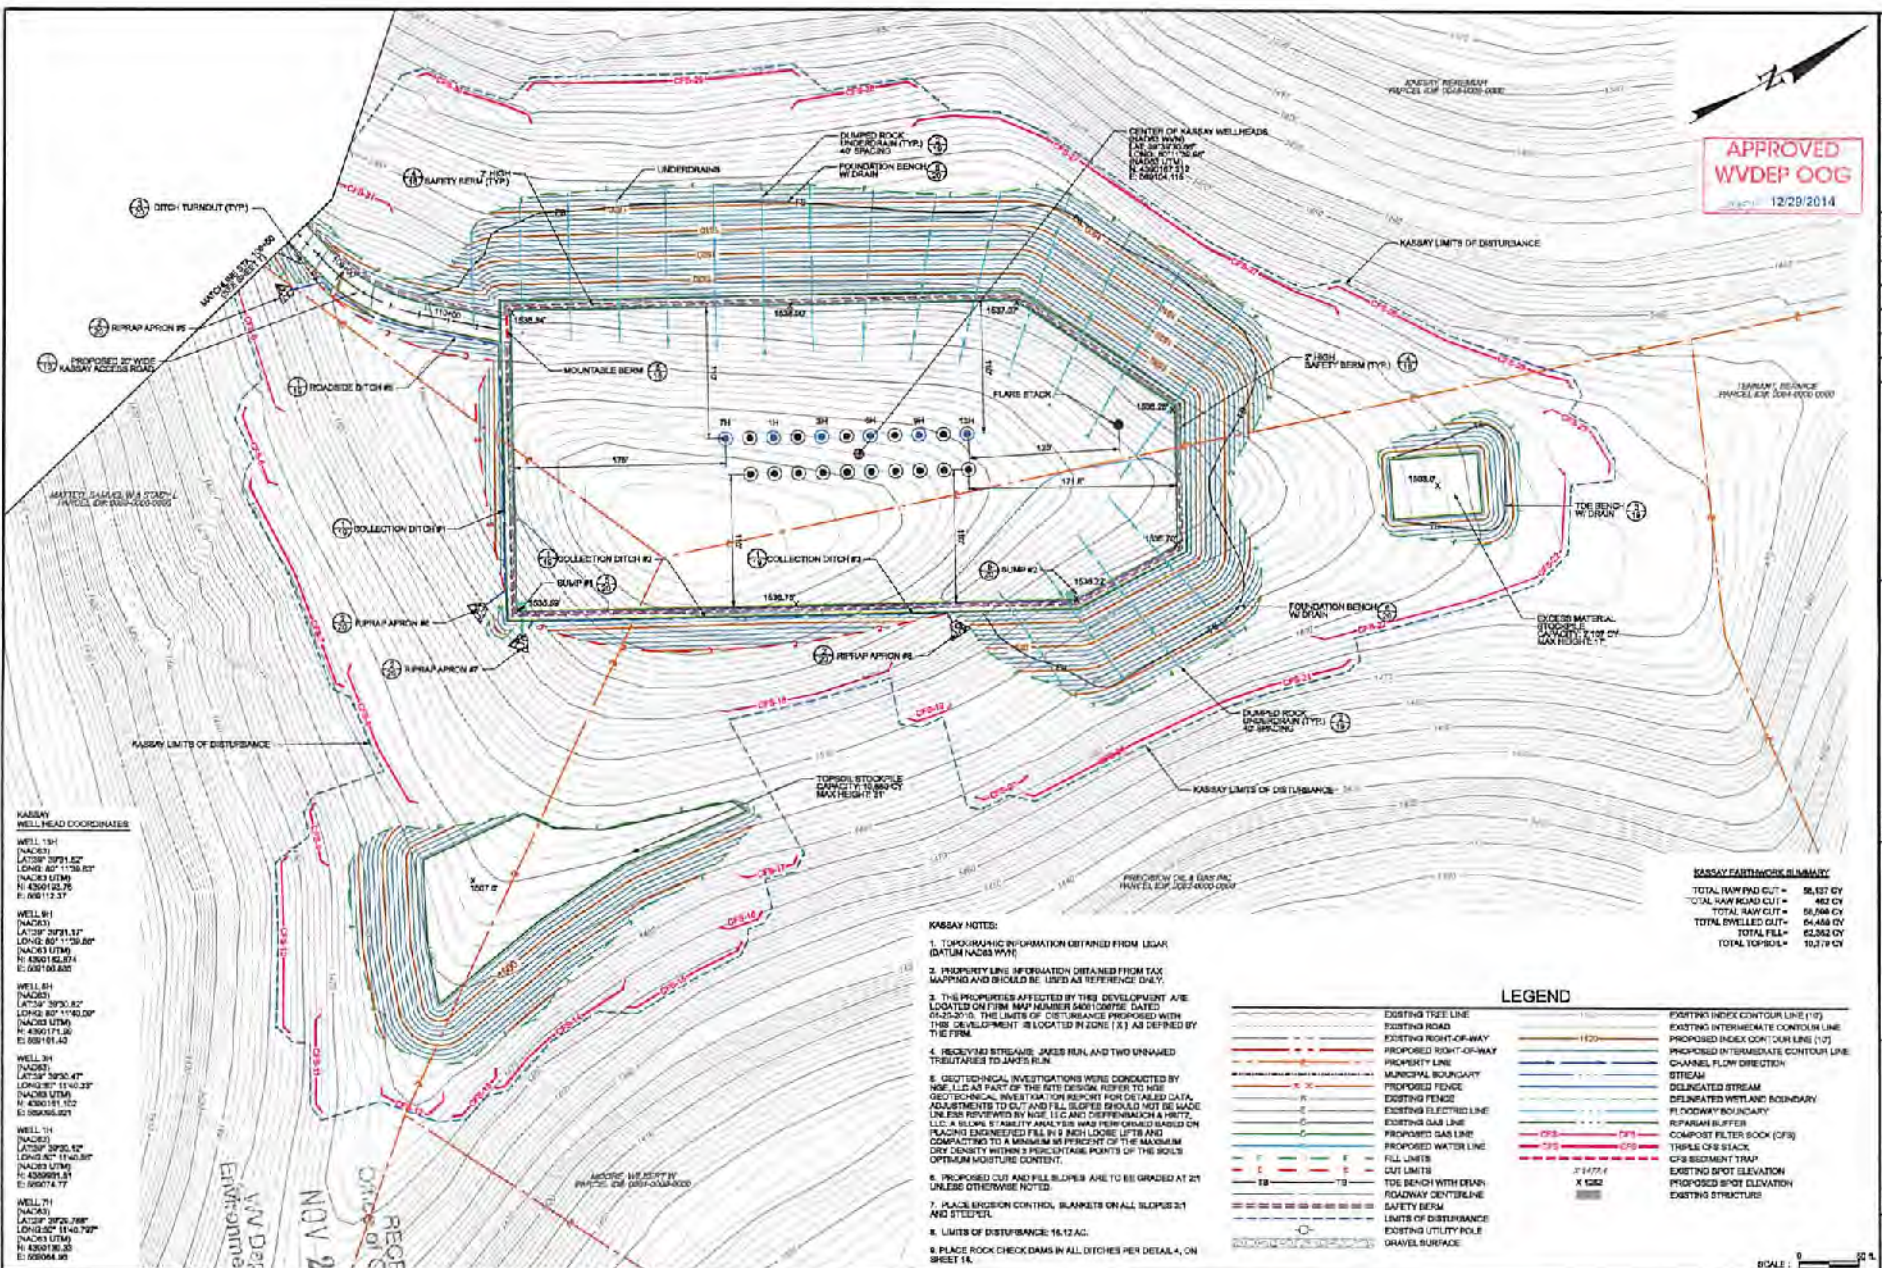

**KASSEY WELLHEAD COORDINATES**







- KASSEY NOTES:**
1. TOPOGRAPHIC INFORMATION OBTAINED FROM LEGAL DATUM NAD83 (WY).
  2. PROPERTY LINE INFORMATION OBTAINED FROM TAX MAPS AND SHOULD BE USED AS REFERENCE ONLY.
  3. THE PROPERTIES AFFECTED BY THIS DEVELOPMENT ARE LOCATED ON THE MAP NUMBER SA010010, DATED 02-20-2010. THE LIMITS OF DISTURBANCE PROPOSED WITH THIS DEVELOPMENT IS LOCATED IN ZONE (X) AS DEFINED BY THE FIRM.
  4. RECEIVED STREAMS, JAMES RUN, AND TWO UNNAMED TRIBUTARIES TO JAMES RUN.
  5. GEOTECHNICAL INVESTIGATIONS WERE CONDUCTED BY HSE LLC AS PART OF THE SITE DESIGN. REPORT TO HSE (GEOTECHNICAL INVESTIGATION REPORT FOR DETAILED DATA ADJUSTMENTS TO CUT AND FILL HEIGHTS) SHOULD NOT BE MADE. LINE ERS REVIEWED BY HSE, LLC AND DIFFERENTIAL A HERTZ, LLC. A BLOW-BY ANALYSIS WAS PERFORMED BASED ON PLACING ENGINEERED FILL IN 8 INCH LAYER LIFT AND COMPACTING TO A MINIMUM 98 PERCENT OF THE MAXIMUM DRY DENSITY WITHIN 8 PROPOSED STAGE POINTS OF THE SOILS OPTIMUM MOISTURE CONTENT.
  6. PROPOSED CUT AND FILL BULDER ARE TO BE GRADDED AT 2% UNLESS OTHERWISE NOTED.
  7. PLACE EROSION CONTROL, BLANKETS ON ALL SLOPES 2:1 AND STEEPER.
  8. LIMITS OF DISTURBANCE: 16.12 AC.
  9. PLACE ROCK CHECK DAMS IN ALL DITCHES PER DETAIL 4, ON SHEET 1A.

**LEGEND**

EXISTING TREE LINE	EXISTING INDEX CONTOUR LINE (10')
EXISTING ROAD	EXISTING INTERMEDIATE CONTOUR LINE
EXISTING RIGHT-OF-WAY	PROPOSED INDEX CONTOUR LINE (10')
PROPOSED RIGHT-OF-WAY	PROPOSED INTERMEDIATE CONTOUR LINE
PROPERTY LINE	CHANNEL FLOW DIRECTION
MUNICIPAL BOUNDARY	STREAM
PROPOSED FENCE	DELINEATED STREAM
EXISTING ELECTRIC LINE	DELINEATED W/LAND BOUNDARY
EXISTING GAS LINE	FI ROADWAY BOUNDARY
PROPOSED GAS LINE	REPAIR BUFFER
PROPOSED WATER LINE	COMPOST FILTER ROCK (CFR)
FILL LIMITS	TRIPLE CFR STACK
CUT LIMITS	CFR BEDDING TRAP
TOE BENCH WITH DEBRIS	EXISTING SPOT ELEVATION
ROADWAY CENTERLINE	PROPOSED SPOT ELEVATION
SAFETY BERM	EXISTING STRUCTURES
LIMITS OF DISTURBANCE	
EXISTING UTILITY POLE	
GRAVEL SURFACE	


TOTAL RAW FND CUT	56,137 CY
TOTAL RAW FND CUT	483 CY
TOTAL RAW CUT	56,620 CY
TOTAL FILL	64,488 CY
TOTAL FILL	62,382 CY
TOTAL TOPSOIL	10,174 CY

RECEIVED  
DATE of SH and Gas  
NOV 22 2017  
WV Department of  
Environmental Protection